

1- ALUMINUM ENTRANCES & STOREFRONTS
2- ALUMINUM CURTAIN WALLS

426 North Ingalls
Ann Arbor, Michigan

RDG Planning & Design
900 Farnam on the Mall, Suite 100
Omaha, NE. 68102
402.392.0133 tel.
402.392.0413 fax

Kallman McKinnell & Wood Architects
109 Kingston Street, 4th Floor
Boston, MA 02111
617.267.0808 tel.
617.267.6999 fax

ADDENDUM

3056 Walker Ridge DR. NW,
Suite G
Walker, Michigan 49544
800-866-2227


R1: C 3X6 – STL. CHN. (168")	
R2: C 3X6 – STL. CHN. (120")	
R3: C 4X7.2 – STL. CHN. (144")	
R4: C 4X5.4 – STL. CHN (120")	
R5: HSS 4X2X3/16" – STL. TUBE (60")	
R6: C 5X9 – STL. CHANNEL (144")	
R7: HSS 4X2X3/8" – STL. TUBE (216")	
R8: HSS 4X2X3/8" – STL. TUBE (60")	
R9: HSS 4X2X3/8" (84") STL. TUBE OR 4"x1" STL. BAR (84")	
R10: HSS 4X2X3/8" STL. TUBE (144")	
R11: HSS 4X2X3/8" STL. TUBE (216")	
R12: HSS 4X2X3/8" STL. TUBE (240")	
R13: HSS 4X2X3/8" STL. TUBE (72")	
R14: HSS 4X2X3/8" STL. TUBE (168")	

THESE SHOP DRAWINGS ARE AN INTERPRETATION OF THE CONTRACT DOCUMENTS. IT SHALL BE THE RESPONSIBILITY OF THE GENERAL CONTRACTOR / CONSTRUCTION MANAGER AND THE ARCHITECT TO REVIEW THESE DRAWINGS FOR COMPLIANCE WITH THE DESIGN INTENT AND CONTRACT DOCUMENTS. WHEN THESE DRAWINGS ARE RETURNED WITH "APPROVED", "APPROVED AS NOTED", OR "REVIEWED" STAMPED ON THEM, IT SHALL CONSTITUTE THE GENERAL CONTRACTOR / CONSTRUCTION MANAGER AND THE ARCHITECT AGREEMENT THAT THE SHOP DRAWINGS DO COMPLY WITH THE DESIGN INTENT AND THE CONTRACT DOCUMENTS AS NOTED WITH IN.

WHEN COPIES OF THESE SHOP DRAWINGS ARE GIVEN TO OTHER TRADES FOR COORDINATION PURPOSES. THOSE TRADES HAVE TO BE AWARE THAT ALL DIMENSIONS ON THE SHOP DRAWINGS ARE SUBJECT FOR FIELD VERIFICATION.


LIST OF DRAWINGS		
SHEET #	DESCRIPTION	SCALE
1.1	TITLE SHEET	NTS
1.2	KEY PLAN	NTS
1.3	KEY PLAN	NTS
1.4	KEY PLAN	NTS
1.5	KEY PLAN	NTS
1.6	KEY PLAN	NTS
1.7	SCHEDULES	NTS
2.1	ELEVATIONS	1/2" = 1'-0"
2.2	ELEVATIONS	1/2" = 1'-0"
2.3	ELEVATIONS	1/2" = 1'-0"
2.4	ELEVATIONS	1/2" = 1'-0"
2.5	ELEVATIONS	1/2" = 1'-0"
2.6	ELEVATIONS	1/2" = 1'-0"
2.6A	ELEVATIONS	1/2" = 1'-0"
2.7	ELEVATIONS	1/2" = 1'-0"
2.8	ELEVATIONS	1/2" = 1'-0"
2.9	ELEVATIONS	1/4" = 1'-0"
2.10	ELEVATIONS	1/4" = 1'-0"
2.11	ELEVATIONS	1/4" = 1'-0"
2.12	ELEVATIONS	1/4" = 1'-0"
2.13	ELEVATIONS	1/4" = 1'-0"
2.14	ELEVATIONS	1/2" = 1'-0"
2.15	ELEVATIONS	1/2" = 1'-0"
2.16	ELEVATIONS	1/2" = 1'-0"
2.17	ELEVATIONS	1/2" = 1'-0"
2.18	ELEVATIONS	1/2" = 1'-0"
2.19	ELEVATIONS	1/2" = 1'-0"
2.20	ELEVATIONS	1/2" = 1'-0"
3.1	DETAILS	FULL
3.2	DETAILS	FULL
3.3	DETAILS	FULL
3.4	DETAILS	FULL
3.5	DETAILS	FULL
3.6	DETAILS	FULL
3.7	DETAILS	FULL
3.8	DETAILS	FULL
3.9	DETAILS	FULL
3.10	DETAILS	FULL
3.11	DETAILS	FULL
3.12	DETAILS	FULL
3.26A	DETAILS	FULL
3.27	DETAILS	FULL
3.28	DETAILS	FULL
GENERAL NOTES		REVISIONS		PROJECT: UNIVERSITY OF MICHIGAN (SCHOOL OF NURSING)		 SABCAD, INC. PROFESSIONAL DRAWINGS P.O BOX 336 CLAWSON, MI 48017 PH: (248) 635-9155 FAX: (248) 282-0595 www.sabcadinc.com				SHEET DESCRIPTION		SCALE: NTS	
* ALL DIMENSIONS TO BE VERIFIED IN FIELD		FIRST ISSUE: 11/20/2013		PROJECT NO: 2011.153.00						TITLE SHEET		SHEET NO. 1.1	
		02/24/2014		LAST UPDATE: 06-28-2013									
* ALL ELEVATIONS ARE VIEWED FROM OUTSIDE		06/02/2014		ARCHITECT: RDG Planning & Design									
		09/22/2014		Kallman McKinnell & Wood Architects									
* ALL PARTS NO.(S) TO BE VERIFIED BY THE PURCHASING DEPARTMENT		03/16/2015		C.M: TURNER CONSTRUCTION COMPANY									
		Engineering review and calculations											
		ASI-15											

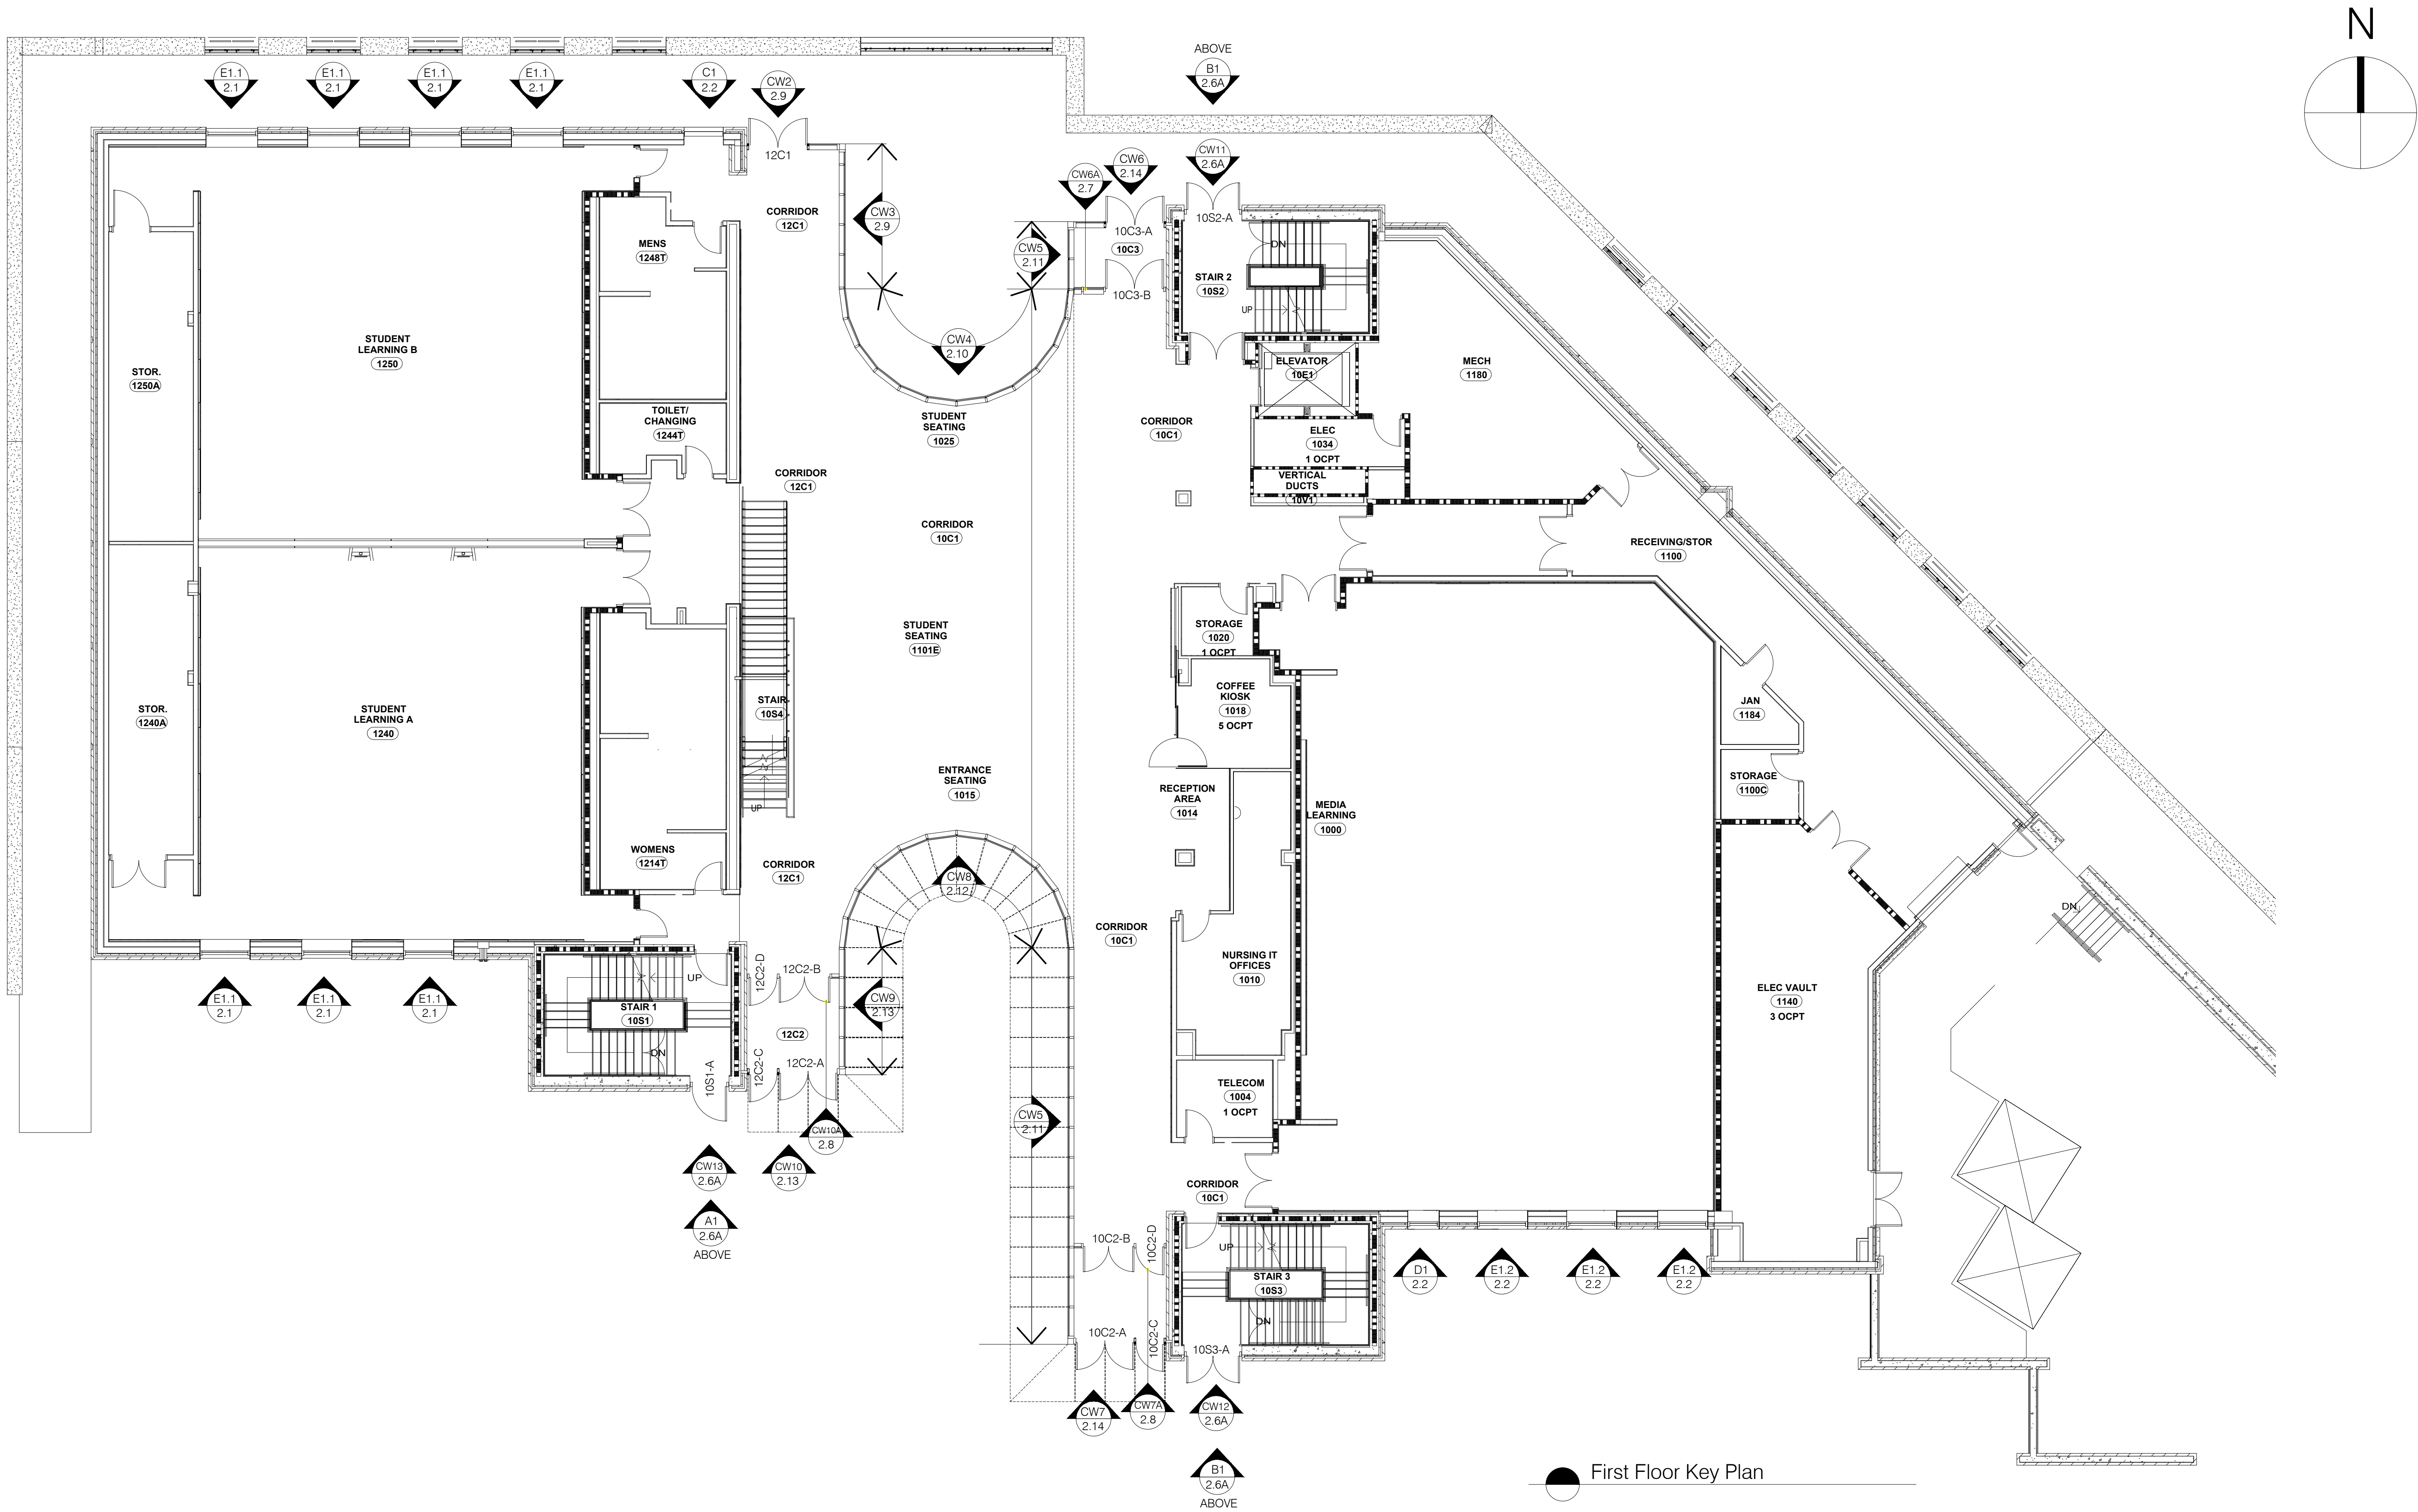


First Floor Key Plan

GENERAL NOTES		REVISIONS		PROJECT:		UNIVERSITY OF MICHIGAN (SCHOOL OF NURSING)		SHEET DESCRIPTION		SCALE: NTS	
* ALL DIMENSIONS TO BE VERIFIED IN FIELD		FIRST ISSUE: 11/20/2013		PROJECT NO: 2011.153.00				KEY PLAN		SHEET NO.	
* ALL ELEVATIONS ARE VIEWED FROM OUTSIDE		02/24/2014		LAST UPDATE: 06-28-2013						1.3	
		06/02/2014		ARCHITECT: RDG Planning & Design							
		09/22/2014		Kallman McKinnell & Wood Architects							
* ALL PARTS NO.(S) TO BE VERIFIED BY THE PURCHASING DEPARTMENT				C.M: TURNER CONSTRUCTION COMPANY				SABCAD JOB NO. 13-39			

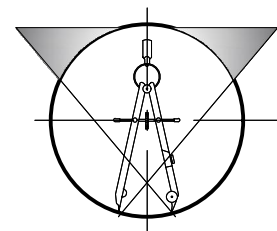

SABCAD, INC.
PROFESSIONAL DRAWINGS

P.O. BOX 336
CLAWSON, MI 48017
PH: (248) 635-9155 FAX: (248) 282-0595
www.sabcadinc.com

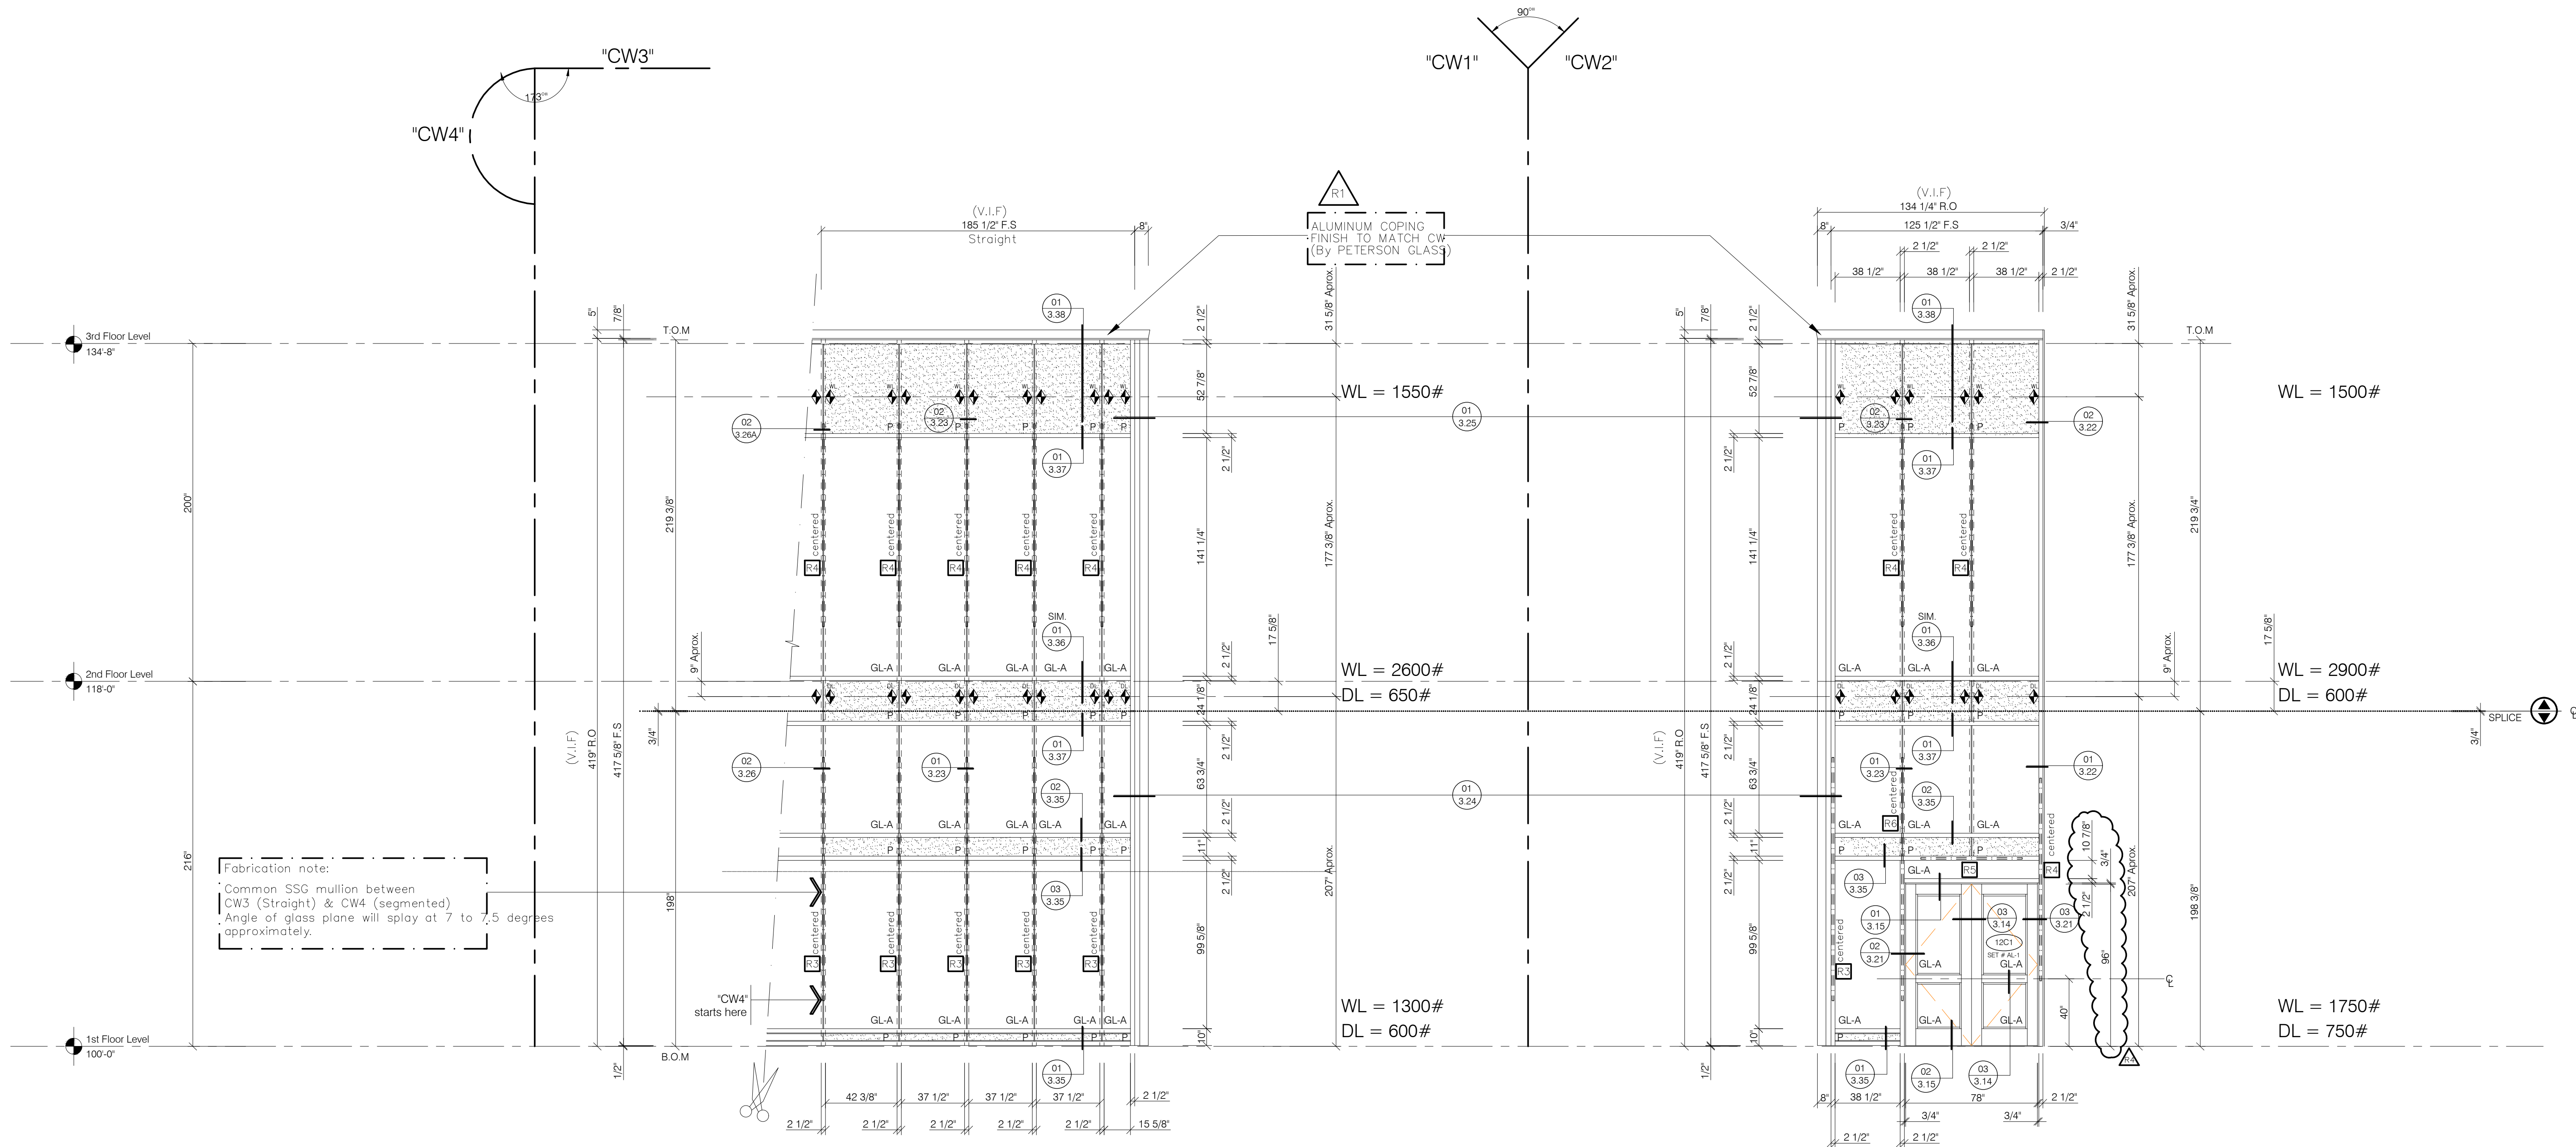

GENERAL NOTES

- * ALL DIMENSIONS TO BE VERIFIED IN FIELD
- * ALL ELEVATIONS ARE VIEWED FROM OUTSIDE
- * ALL PARTS NO.(S) TO BE VERIFIED BY THE PURCHASING DEPARTMENT

REVISIONS

FIRST ISSUE:	11/20/2013
	02/24/2014
Engineering review and calculations	09/22/2014
ASI-15	03/16/2015

PROJECT:

UNIVERSITY OF MICHIGAN (SCHOOL OF NURSING)

PROJECT NO:	2011.153.00
LAST UPDATE:	06-28-2013
ARCHITECT:	RDG Planning & Design
	Kallman McKinnell & Wood Architects
C.M:	TURNER CONSTRUCTION COMPANY

SABCAD, INC.

PROFESSIONAL DRAWINGS

P.O BOX 336
CLAWSON, MI 48017
PH: (248) 635-9155 FAX: (248) 282-0595
www.sabcadinc.com

SHEET DESCRIPTION


ELEVATIONS

SABCAD JOB NO. 13-39


SCALE: 1/4" = 1'-0"

SHEET NO.

2.9

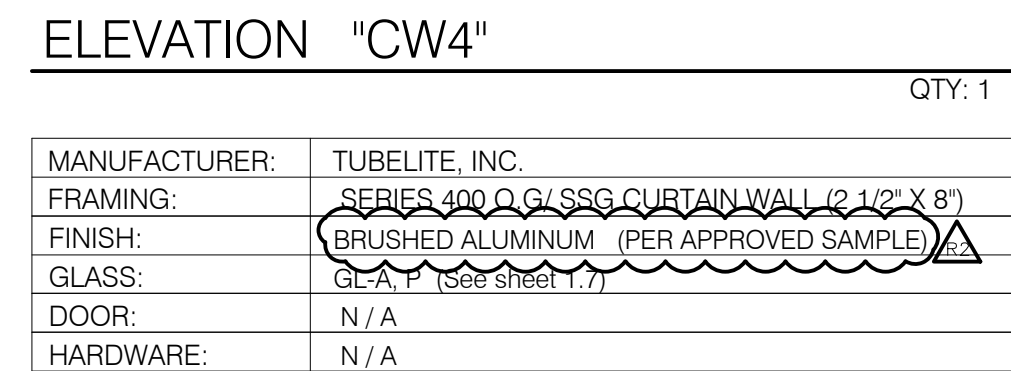

GENERAL NOTES		REVISIONS		PROJECT: UNIVERSITY OF MICHIGAN (SCHOOL OF NURSING)		 SABCAD, INC. PROFESSIONAL DRAWINGS P.O BOX 336 CLAWSON, MI 48017 PH: (248) 635-9155 FAX: (248) 282-0595 www.sabcadinc.com		SHEET DESCRIPTION		SCALE: 1/4" = 1'-0"	
* ALL DIMENSIONS TO BE VERIFIED IN FIELD	FIRST ISSUE: 11/20/2013	PROJECT NO: 2011.153.00		ELEVATIONS				SHEET NO. 2.10			
	 02/24/2014	LAST UPDATE: 06-28-2013									
* ALL ELEVATIONS ARE VIEWED FROM OUTSIDE	 06/02/2014	ARCHITECT: RDG Planning & Design									
	 Engineering review and calculations 09/22/2014	Kallman McKinnell & Wood Architects									
* ALL PARTS NO.(S) TO BE VERIFIED BY THE PURCHASING DEPARTMENT		C.M: TURNER CONSTRUCTION COMPANY									
				SABCAD JOB NO. 13-39							

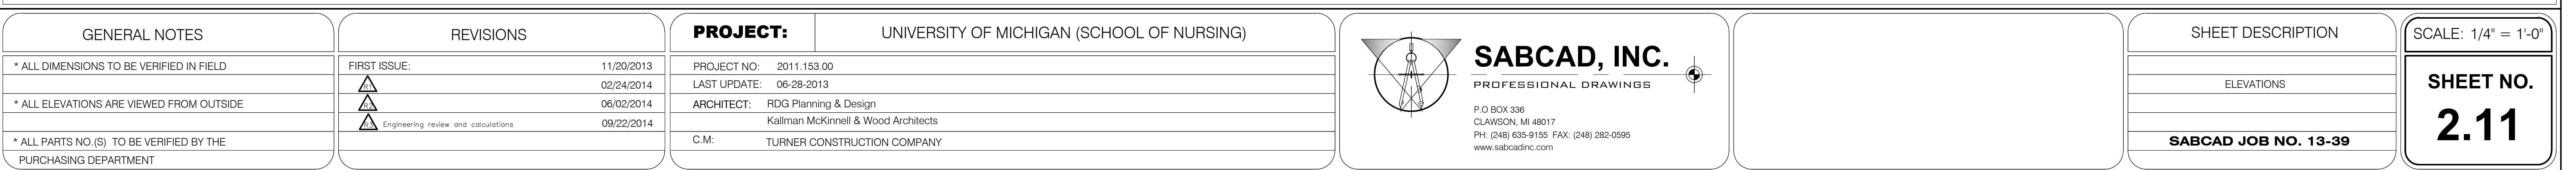





GENERAL NOTES		REVISIONS		PROJECT:		UNIVERSITY OF MICHIGAN (SCHOOL OF NURSING)	
* ALL DIMENSIONS TO BE VERIFIED IN FIELD		FIRST ISSUE:	11/20/2013	PROJECT NO:		2011.153.00	
			02/24/2014	LAST UPDATE:		06-28-2013	
* ALL ELEVATIONS ARE VIEWED FROM OUTSIDE			06/02/2014	ARCHITECT:		RDG Planning & Design	
			09/22/2014			Kalman McKinnell & Wood Architects	
* ALL PARTS NO.(S) TO BE VERIFIED BY THE PURCHASING DEPARTMENT		Engineering review and calculations		C.M.:		TURNER CONSTRUCTION COMPANY	




	SHEET DESCRIPTION	SCALE: FULL
		SHEET NO. 3.5
	DETAILS	
	SABCAD JOB NO. 13-39	

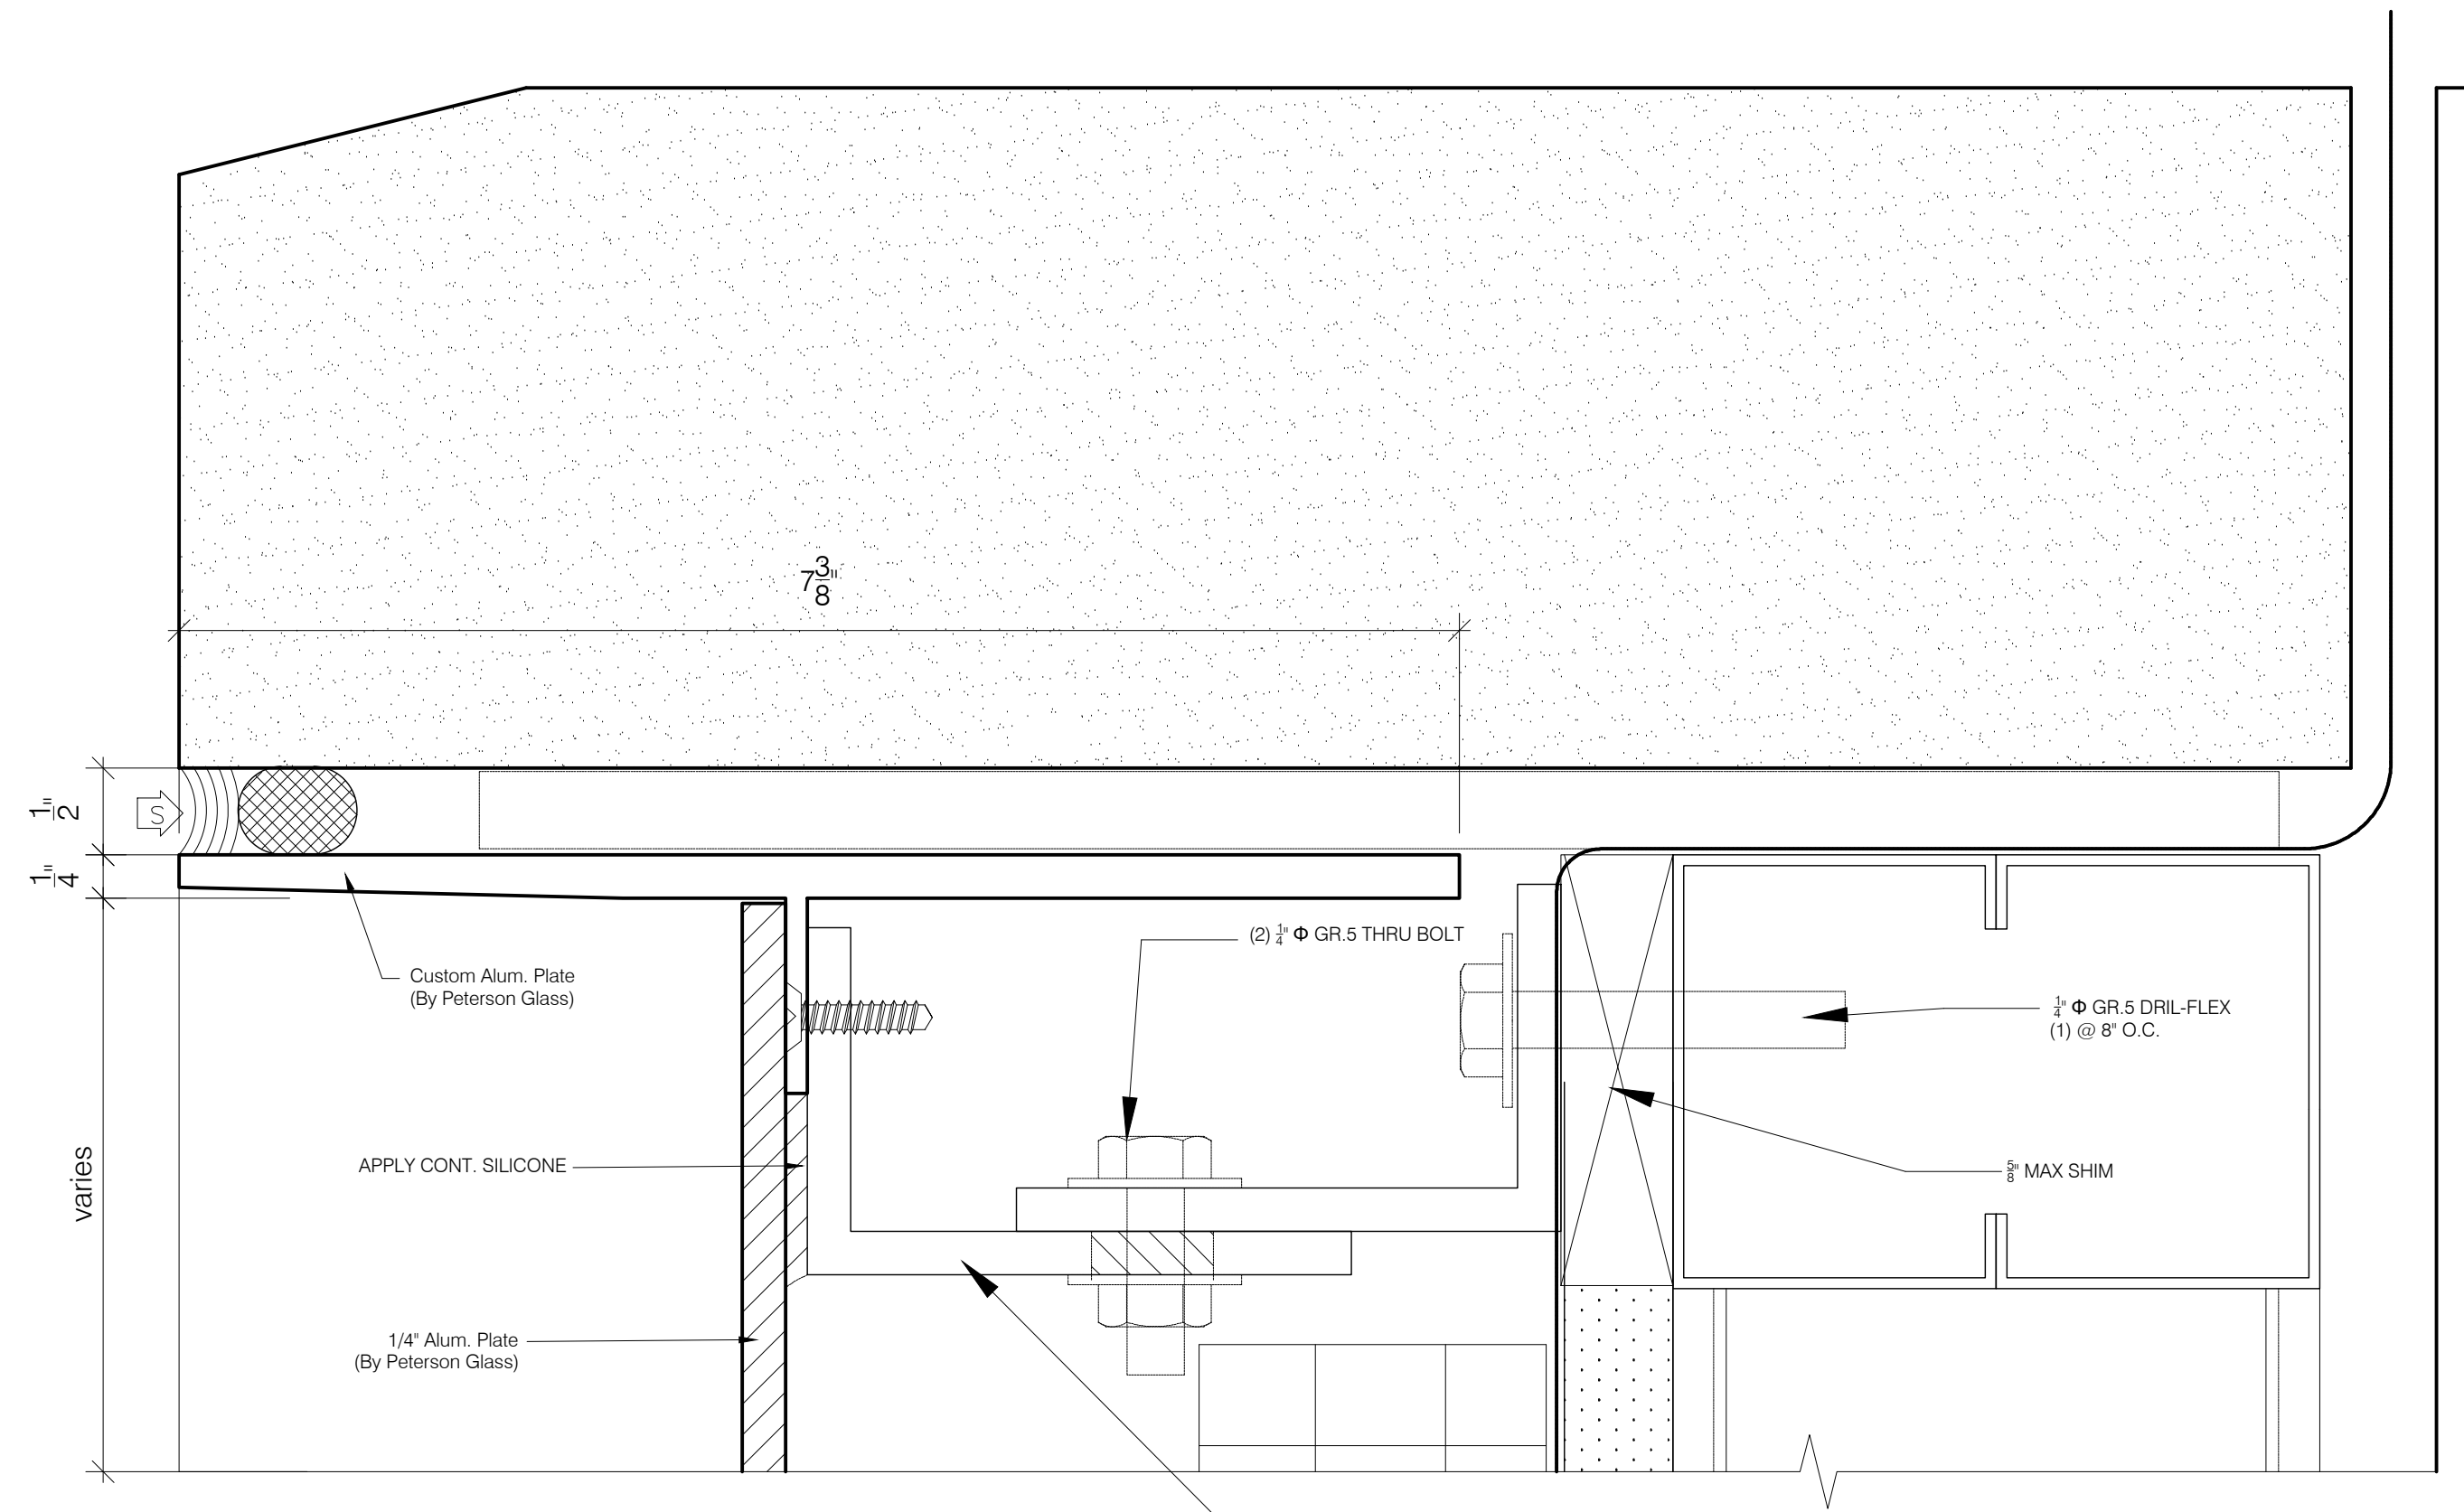


DETAIL 01 / 3.6
Arch Reference: C4 / A09.13

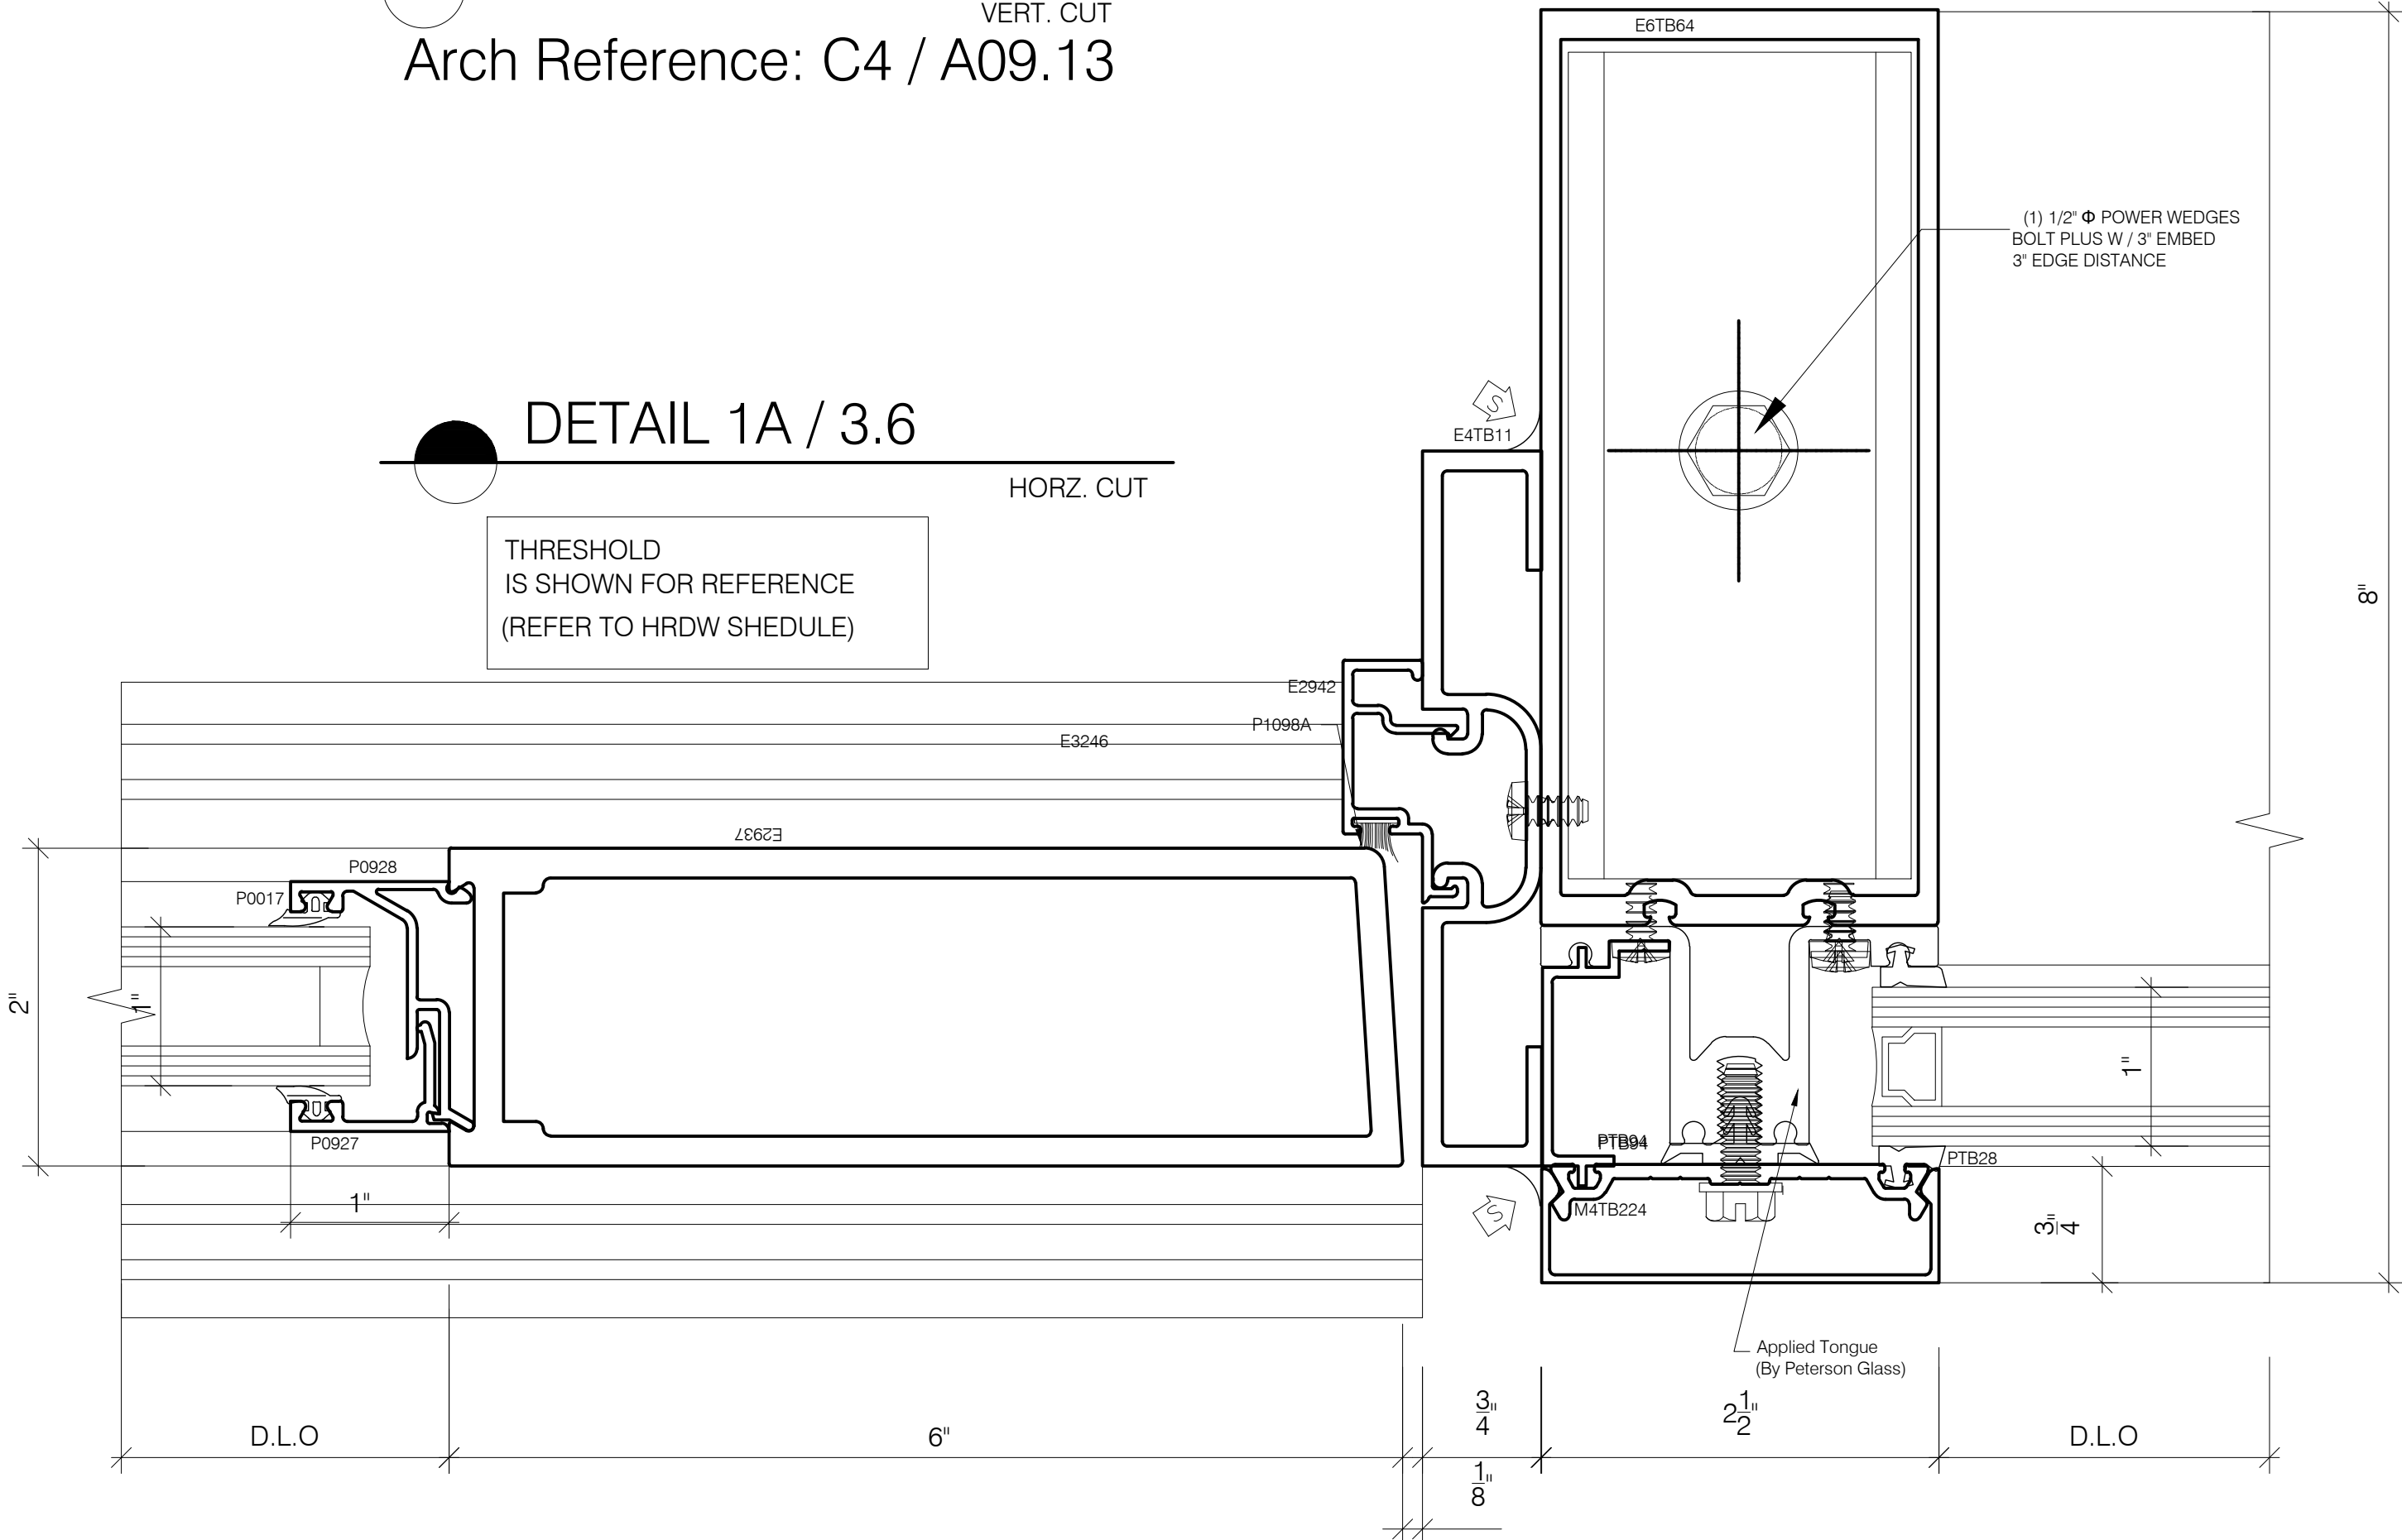



DETAIL 1A / 3.6
Arch Reference: C4 / A09.13

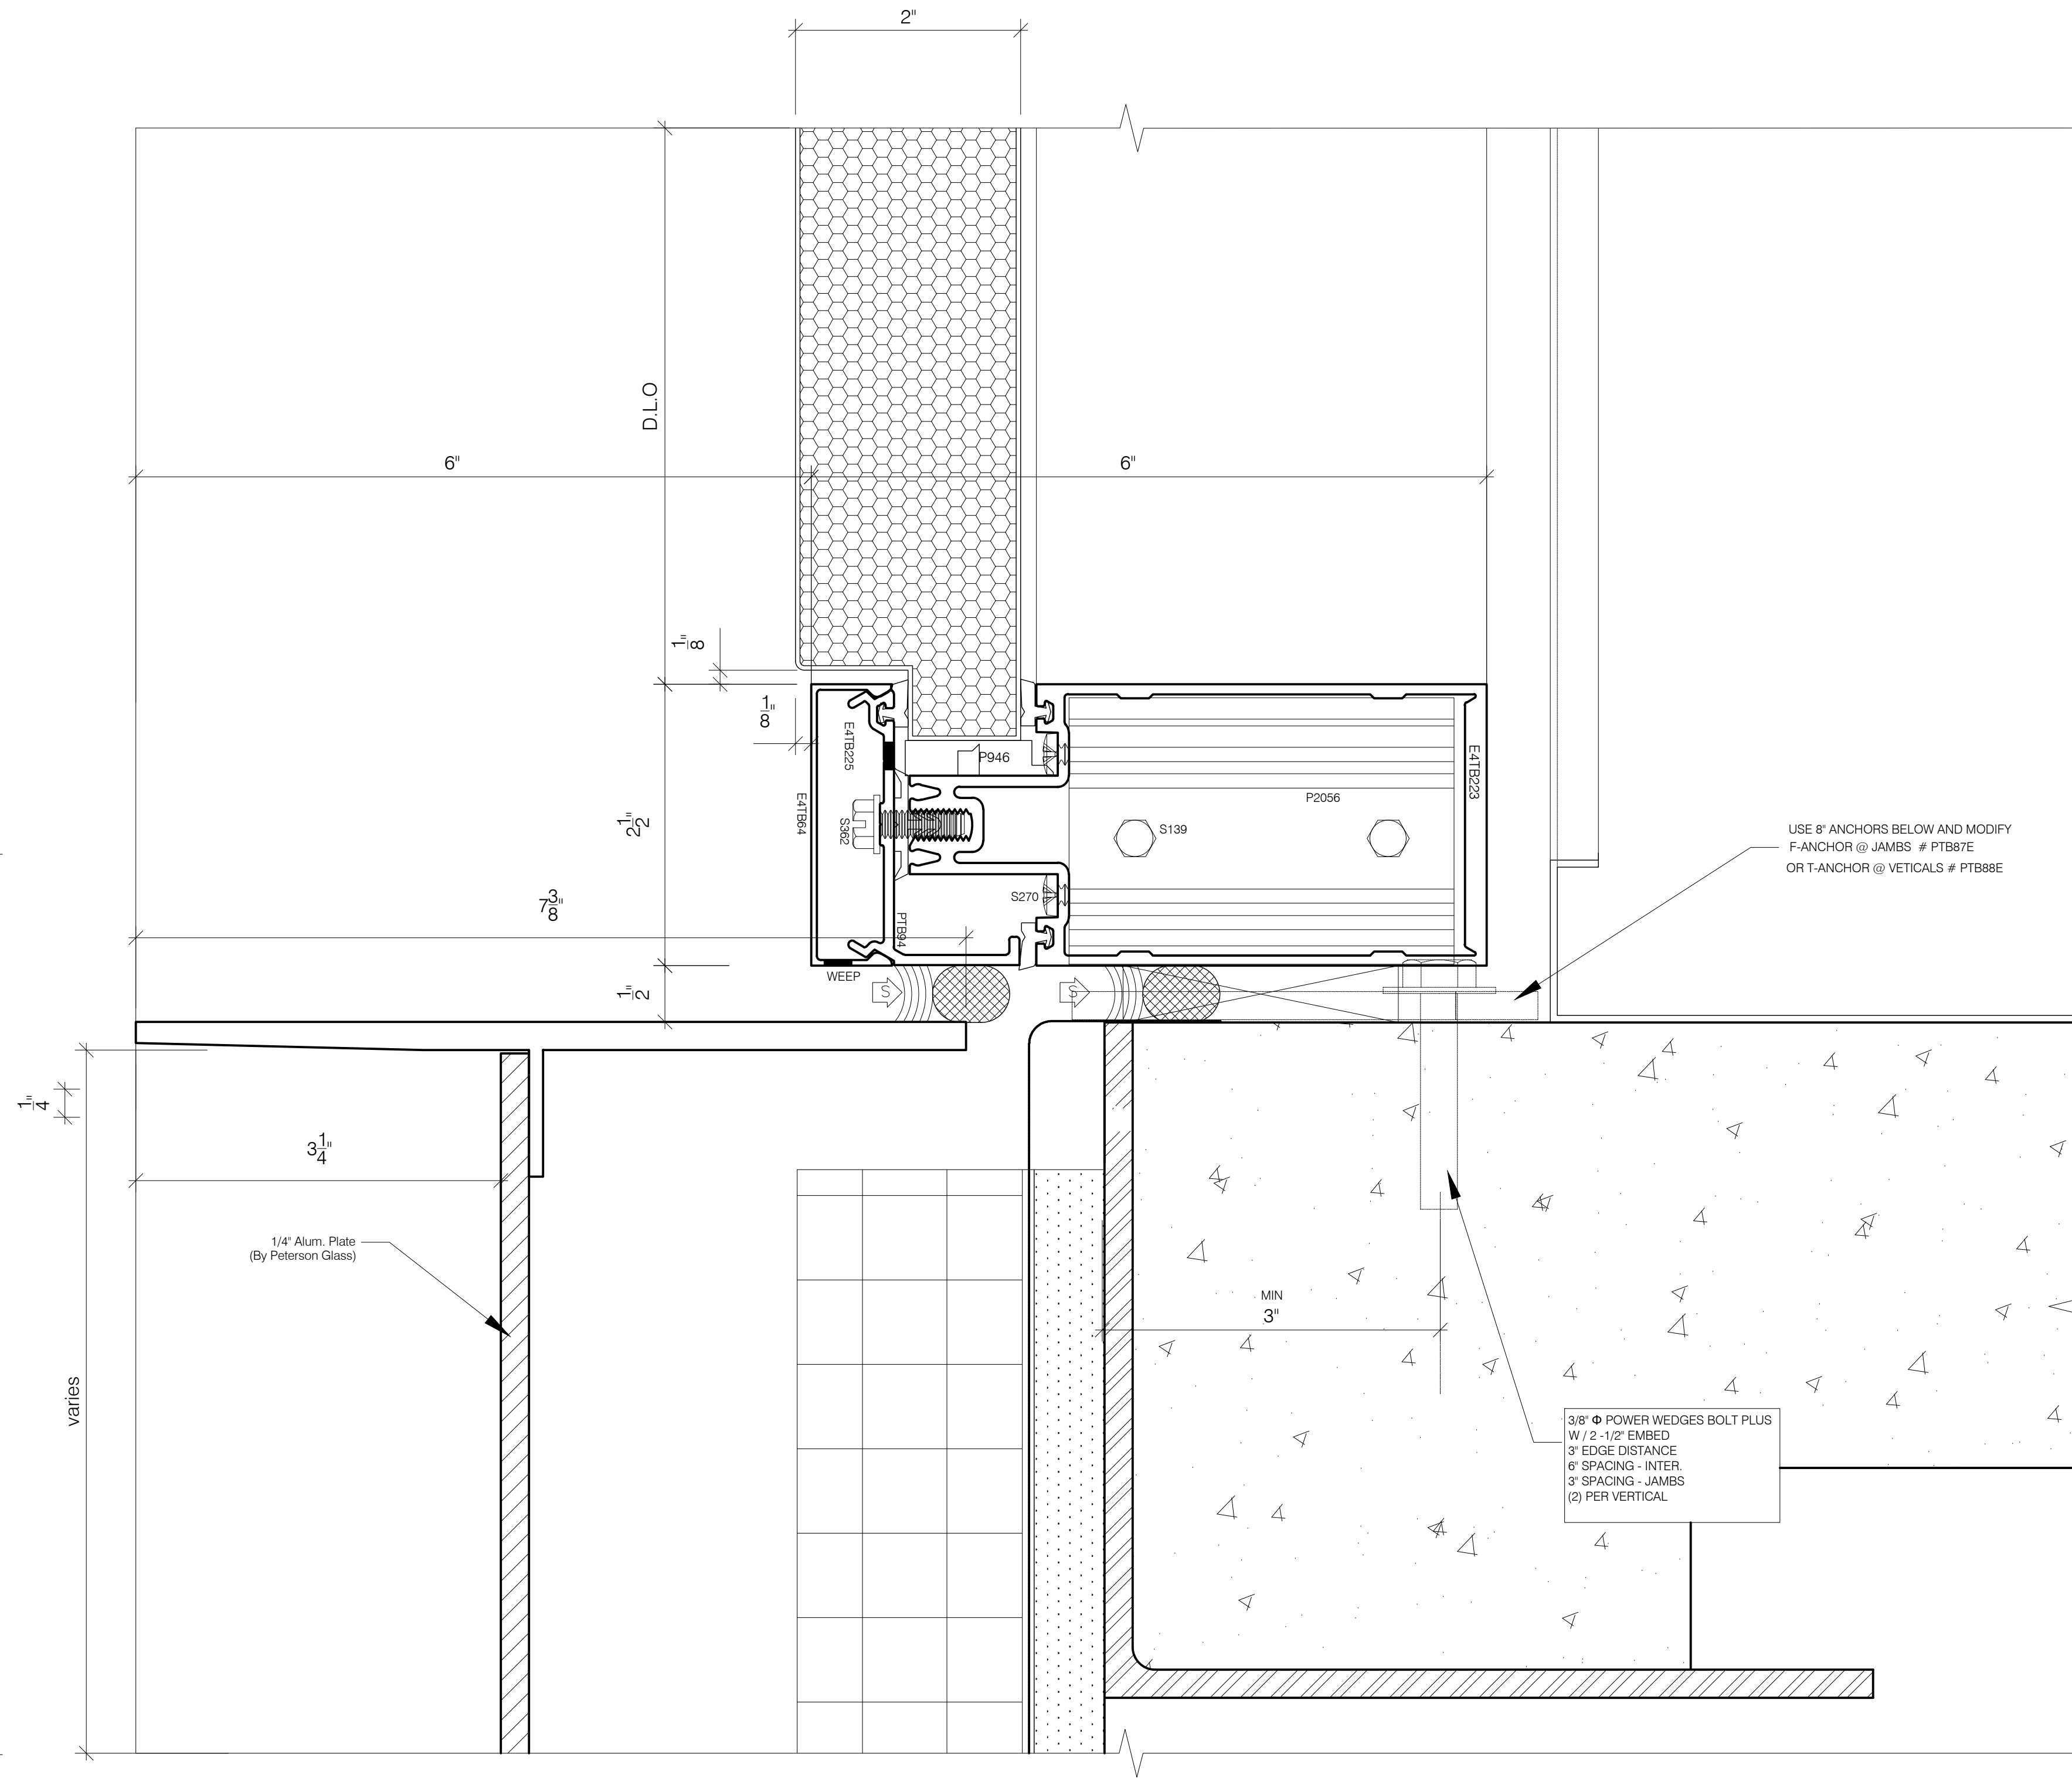



DETAIL 02 / 3.6
Arch Reference: B4 / A09.11

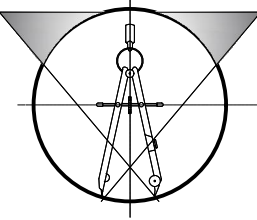
GENERAL NOTES	REVISIONS	PROJECT:	UNIVERSITY OF MICHIGAN (SCHOOL OF NURSING)	SABCAD, INC.		SHEET DESCRIPTION	SCALE: FULL
* ALL DIMENSIONS TO BE VERIFIED IN FIELD	FIRST ISSUE: 11/20/2013	PROJECT NO: 2011.153.00		 SABCAD, INC. PROFESSIONAL DRAWINGS P.O BOX 336 CLAWSON, MI 48017 PH: (248) 635-9155 FAX: (248) 282-0595 www.sabcadinc.com		DETAILS	SHEET NO. 3.6
* ALL ELEVATIONS ARE VIEWED FROM OUTSIDE	02/24/2014	LAST UPDATE: 06-28-2013					
* ALL PARTS NO.(S) TO BE VERIFIED BY THE PURCHASING DEPARTMENT	06/02/2014	ARCHITECT: RDG Planning & Design					
	09/22/2014	Kallman McKinnell & Wood Architects					
		C.M: TURNER CONSTRUCTION COMPANY				SABCAD JOB NO. 13-39	

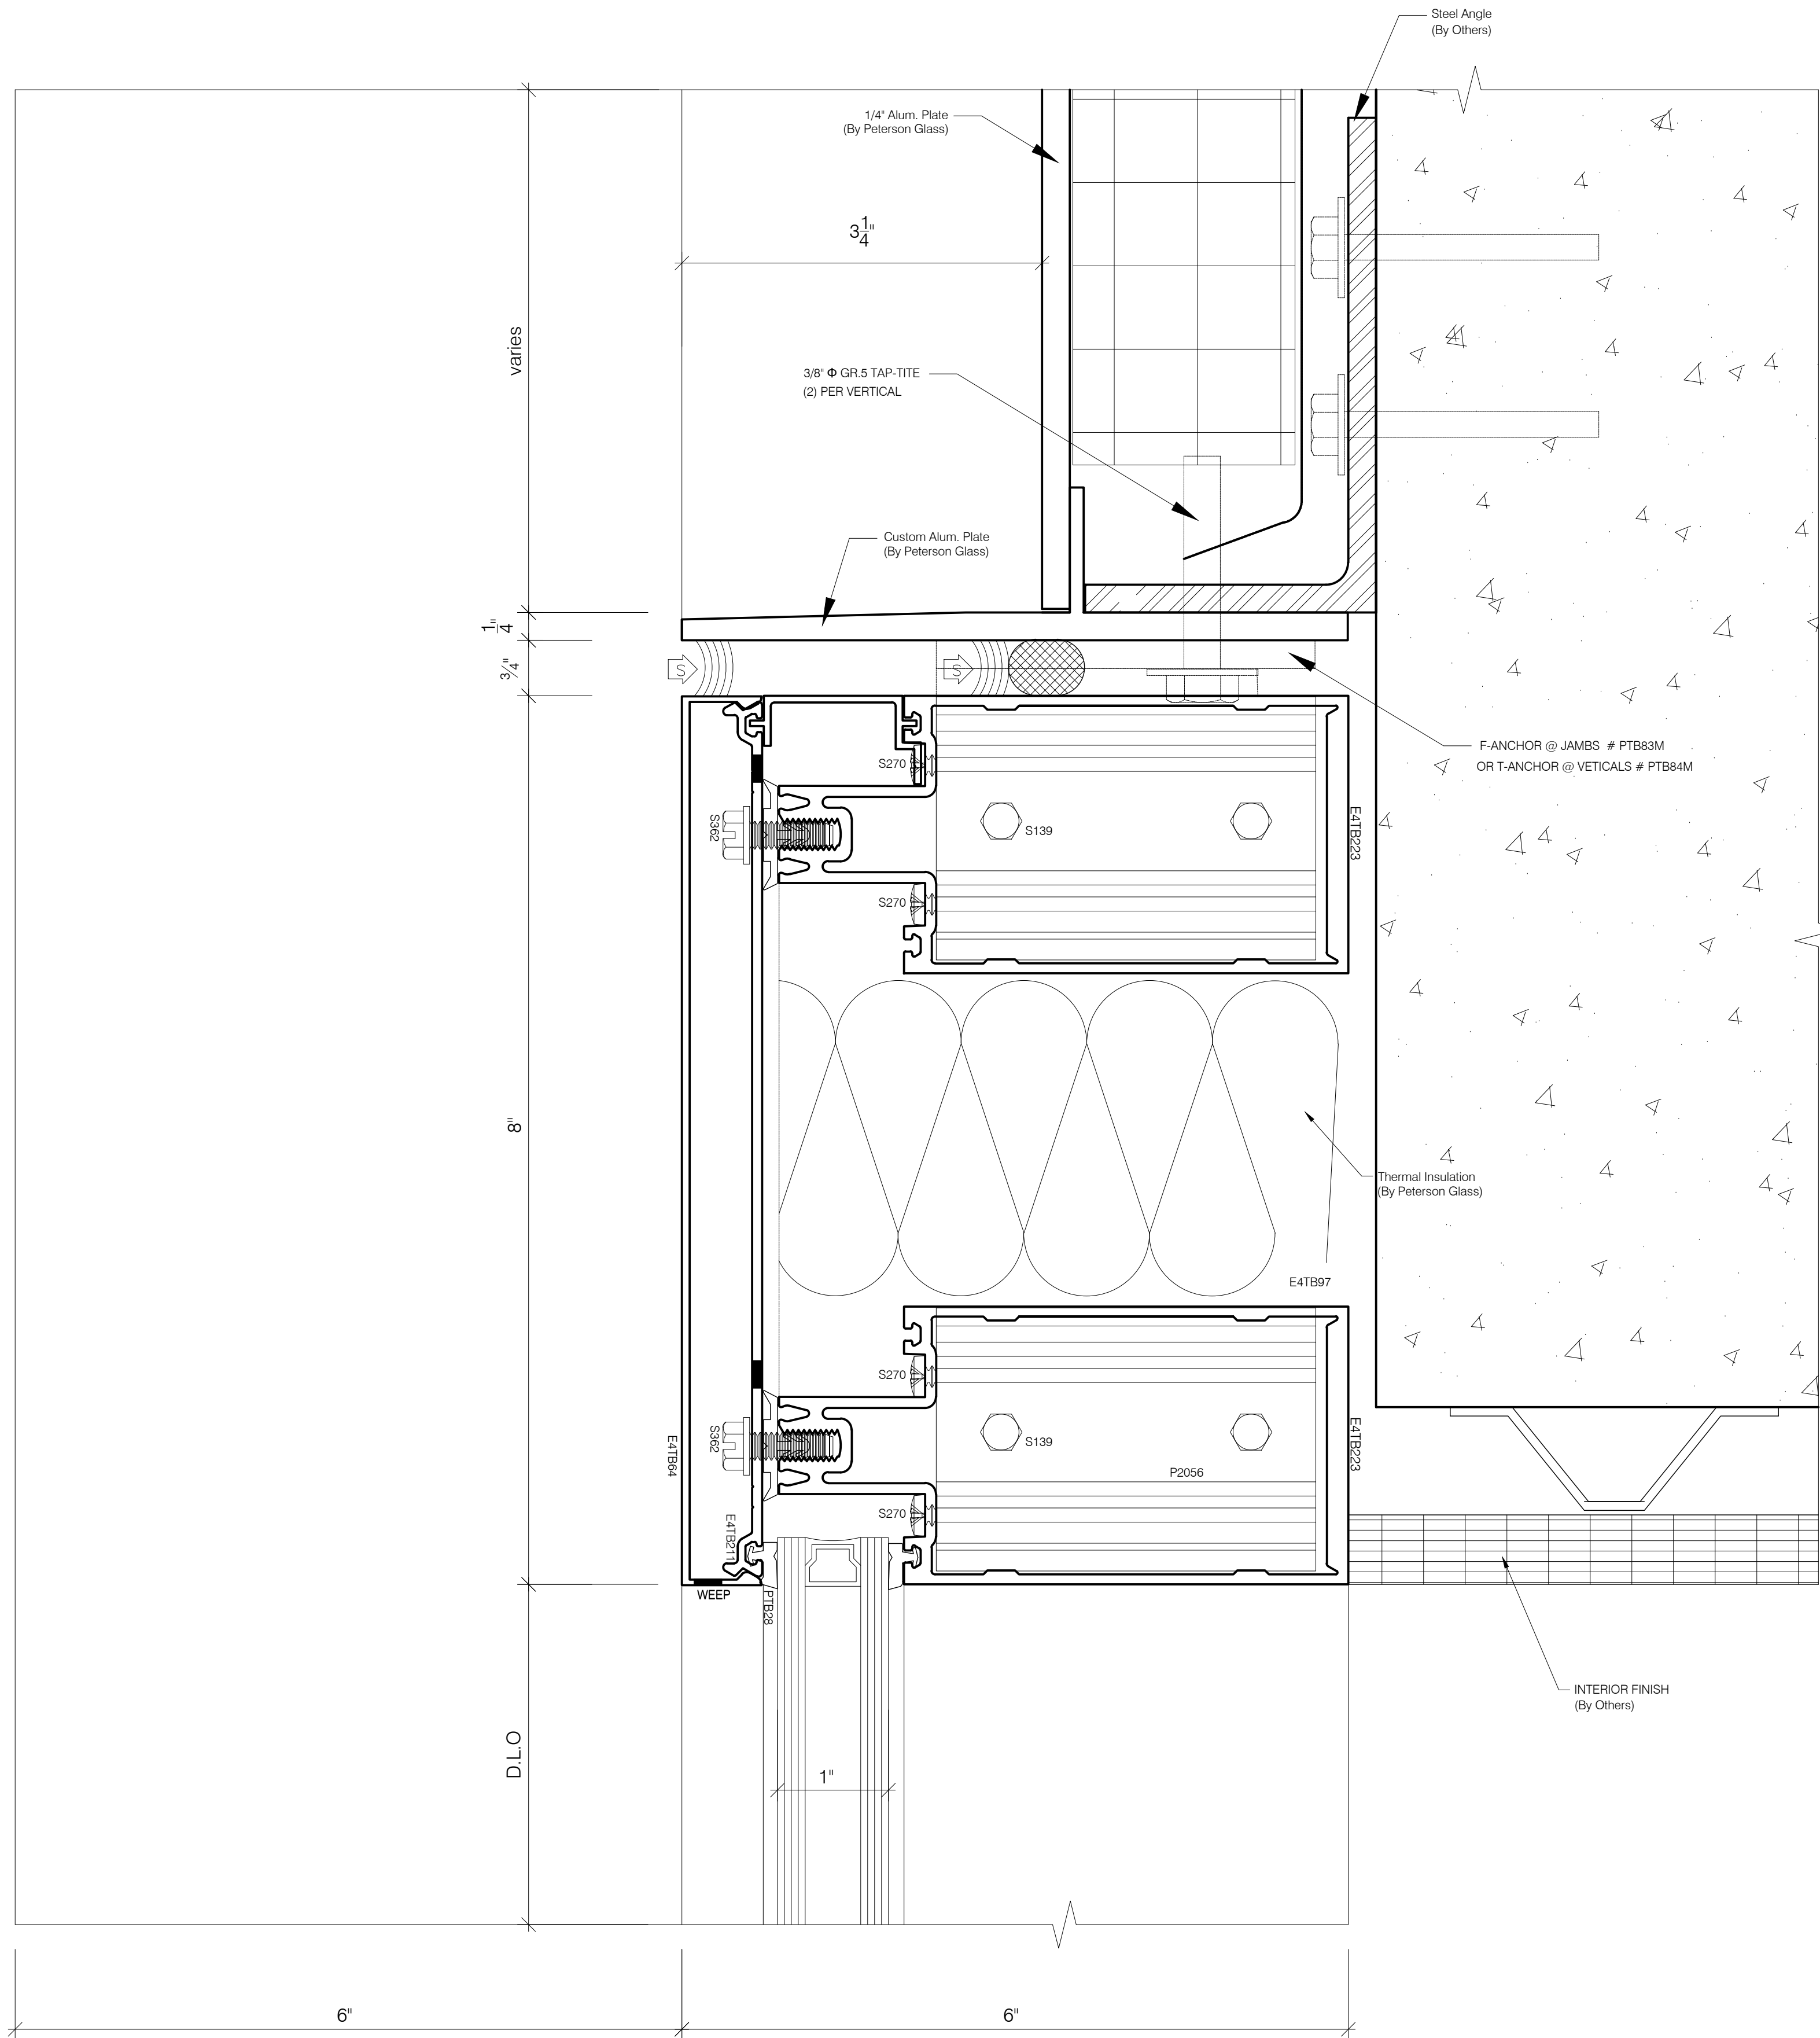


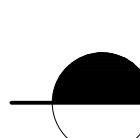
 **DETAIL 01 / 3.9**
VERT. CUT
Arch Reference: C3 / A09.11

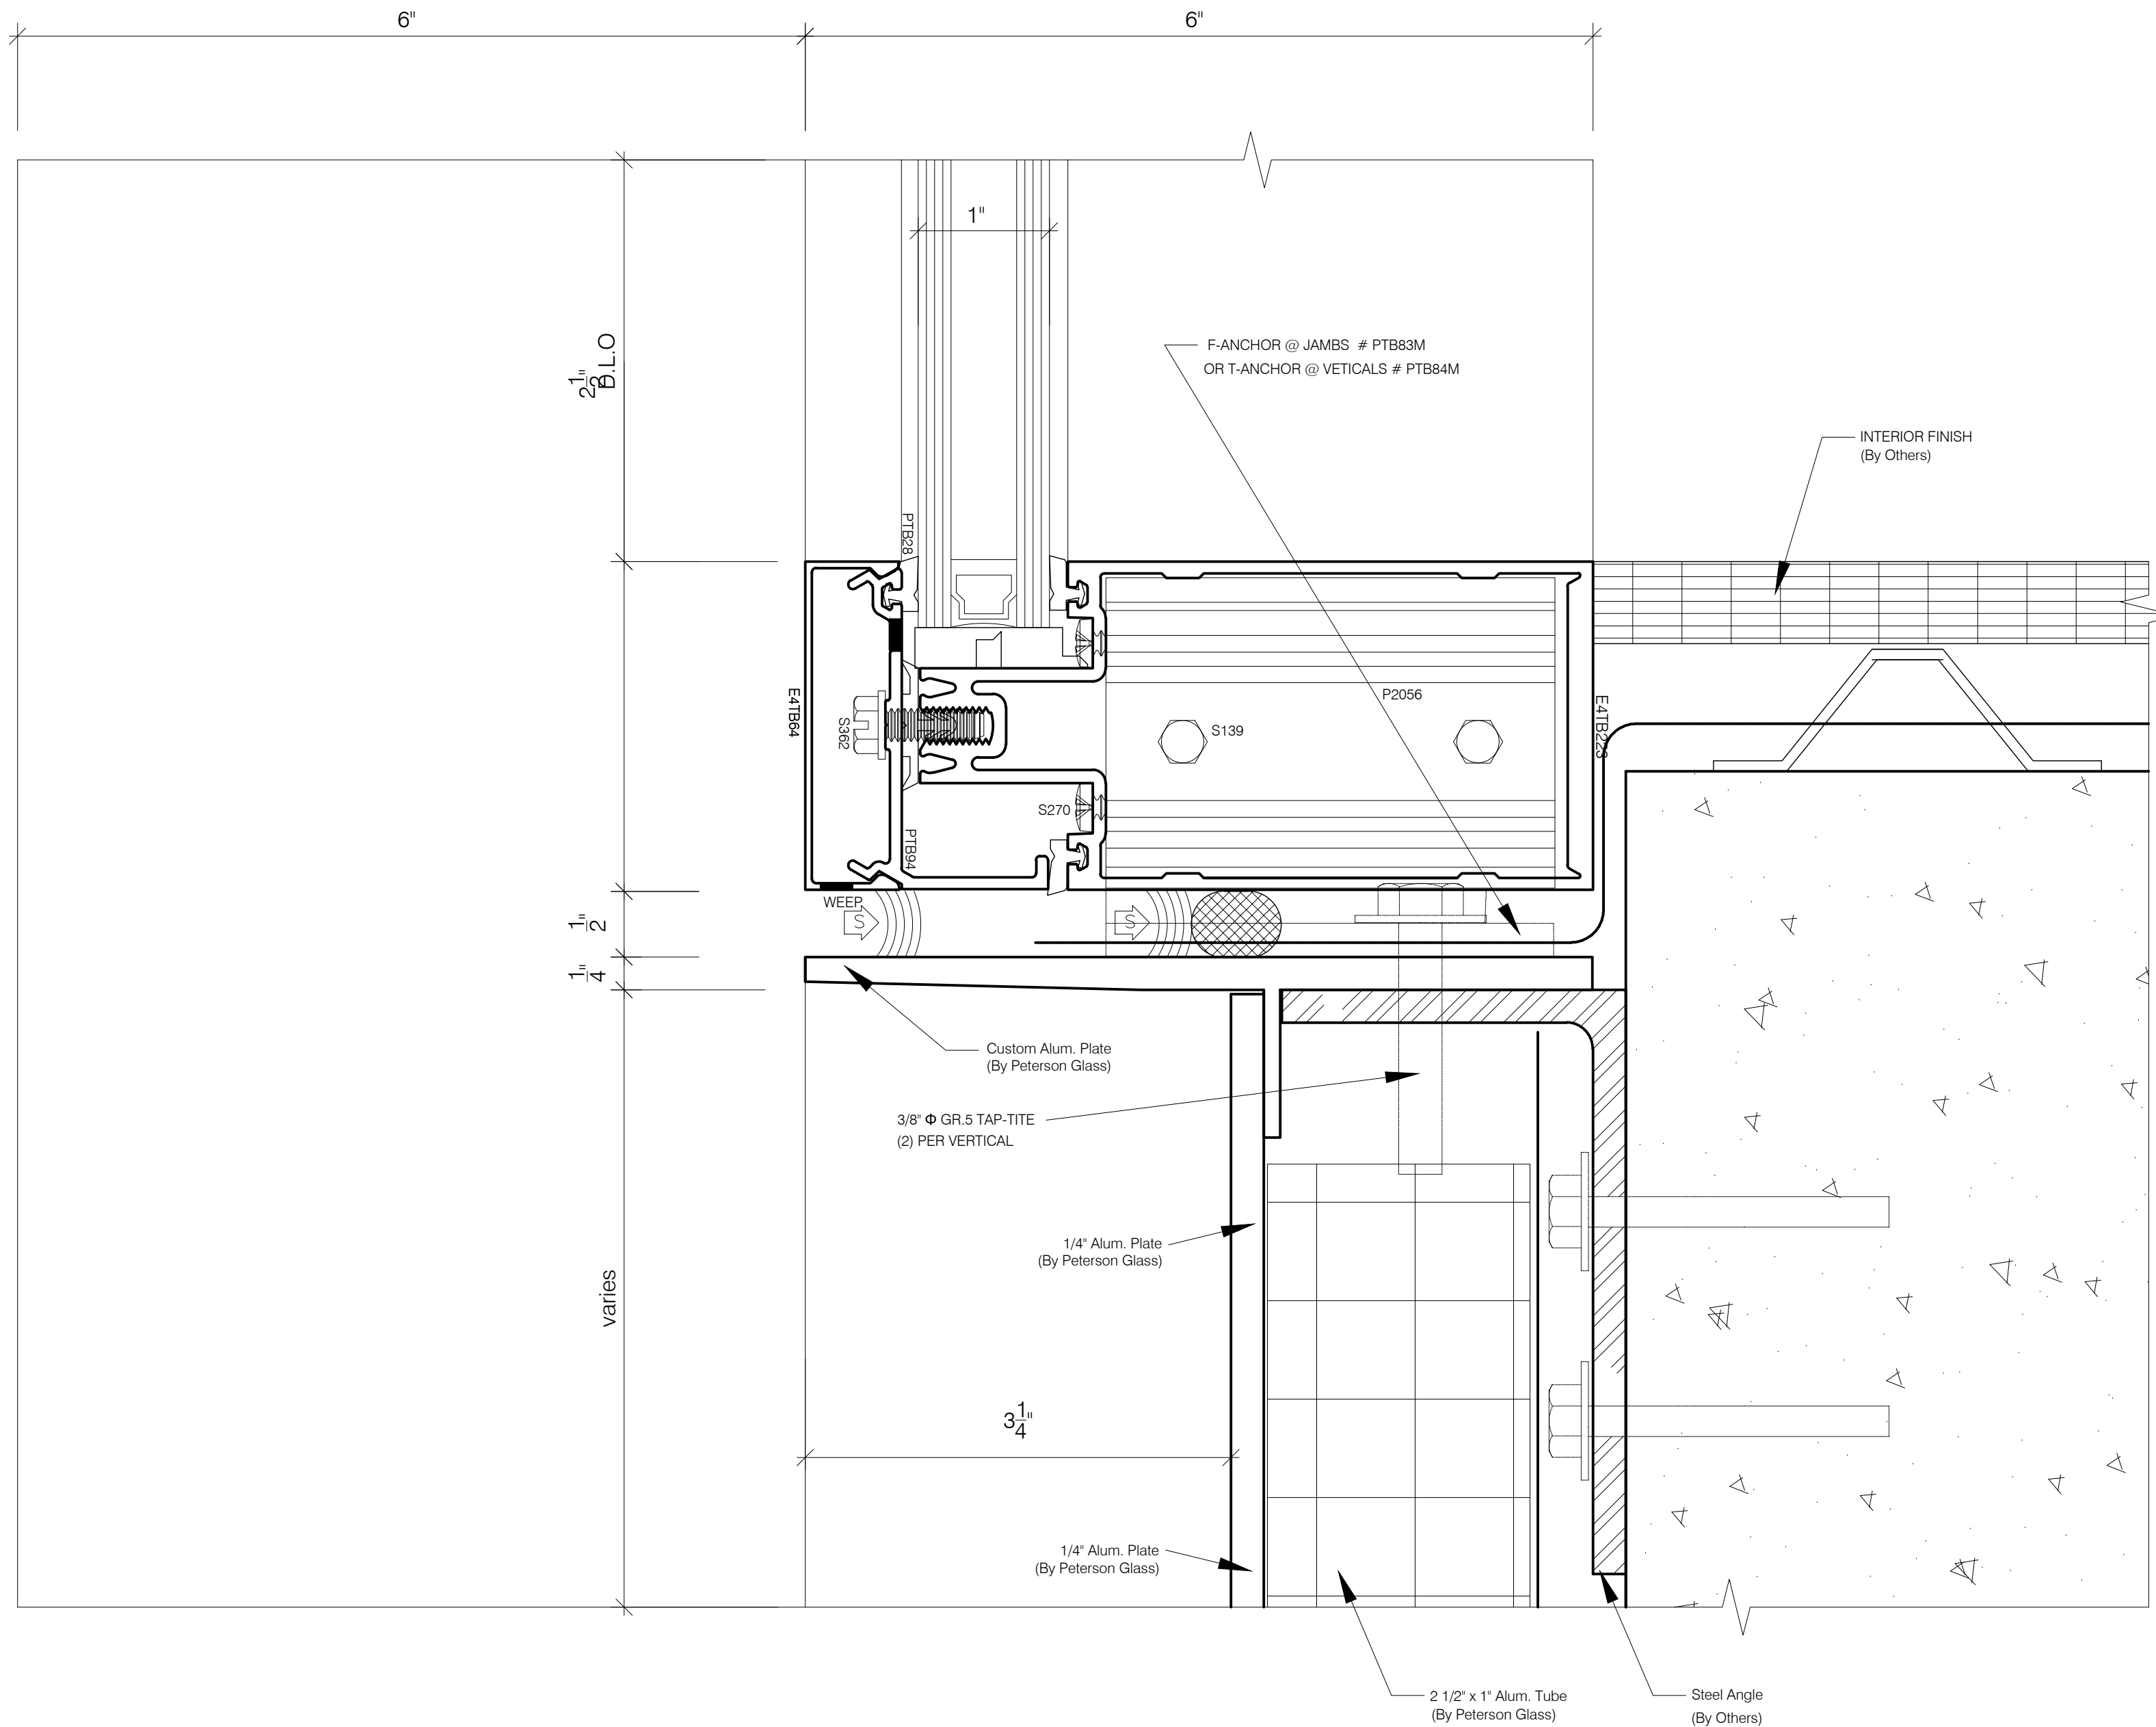

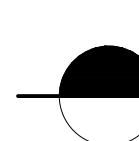
 **DETAIL 02 / 3.9**
VERT. CUT
Arch Reference: C3 / A09.11

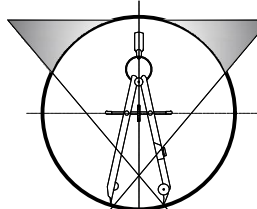GENERAL NOTES		REVISIONS		PROJECT: UNIVERSITY OF MICHIGAN (SCHOOL OF NURSING)		 SABCAD, INC. PROFESSIONAL DRAWINGS P.O BOX 336 CLAWSON, MI 48017 PH: (248) 635-9155 FAX: (248) 282-0595 www.sabcadinc.com	SHEET DESCRIPTION		SCALE: FULL	
* ALL DIMENSIONS TO BE VERIFIED IN FIELD		FIRST ISSUE: 11/20/2013		PROJECT NO: 2011.153.00					SHEET NO. 3.9	
		⚠ 02/24/2014		LAST UPDATE: 06-28-2013						
* ALL ELEVATIONS ARE VIEWED FROM OUTSIDE		⚠ 06/02/2014		ARCHITECT: RDG Planning & Design						
		⚠ 09/22/2014		Kallman McKinnell & Wood Architects						
		Engineering review and calculations		C.M: TURNER CONSTRUCTION COMPANY						
* ALL PARTS NO.(S) TO BE VERIFIED BY THE PURCHASING DEPARTMENT								SABCAD JOB NO. 13-39		

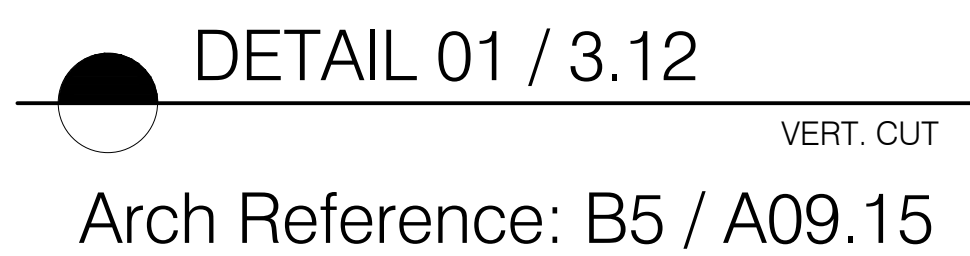
SABCAD, INC

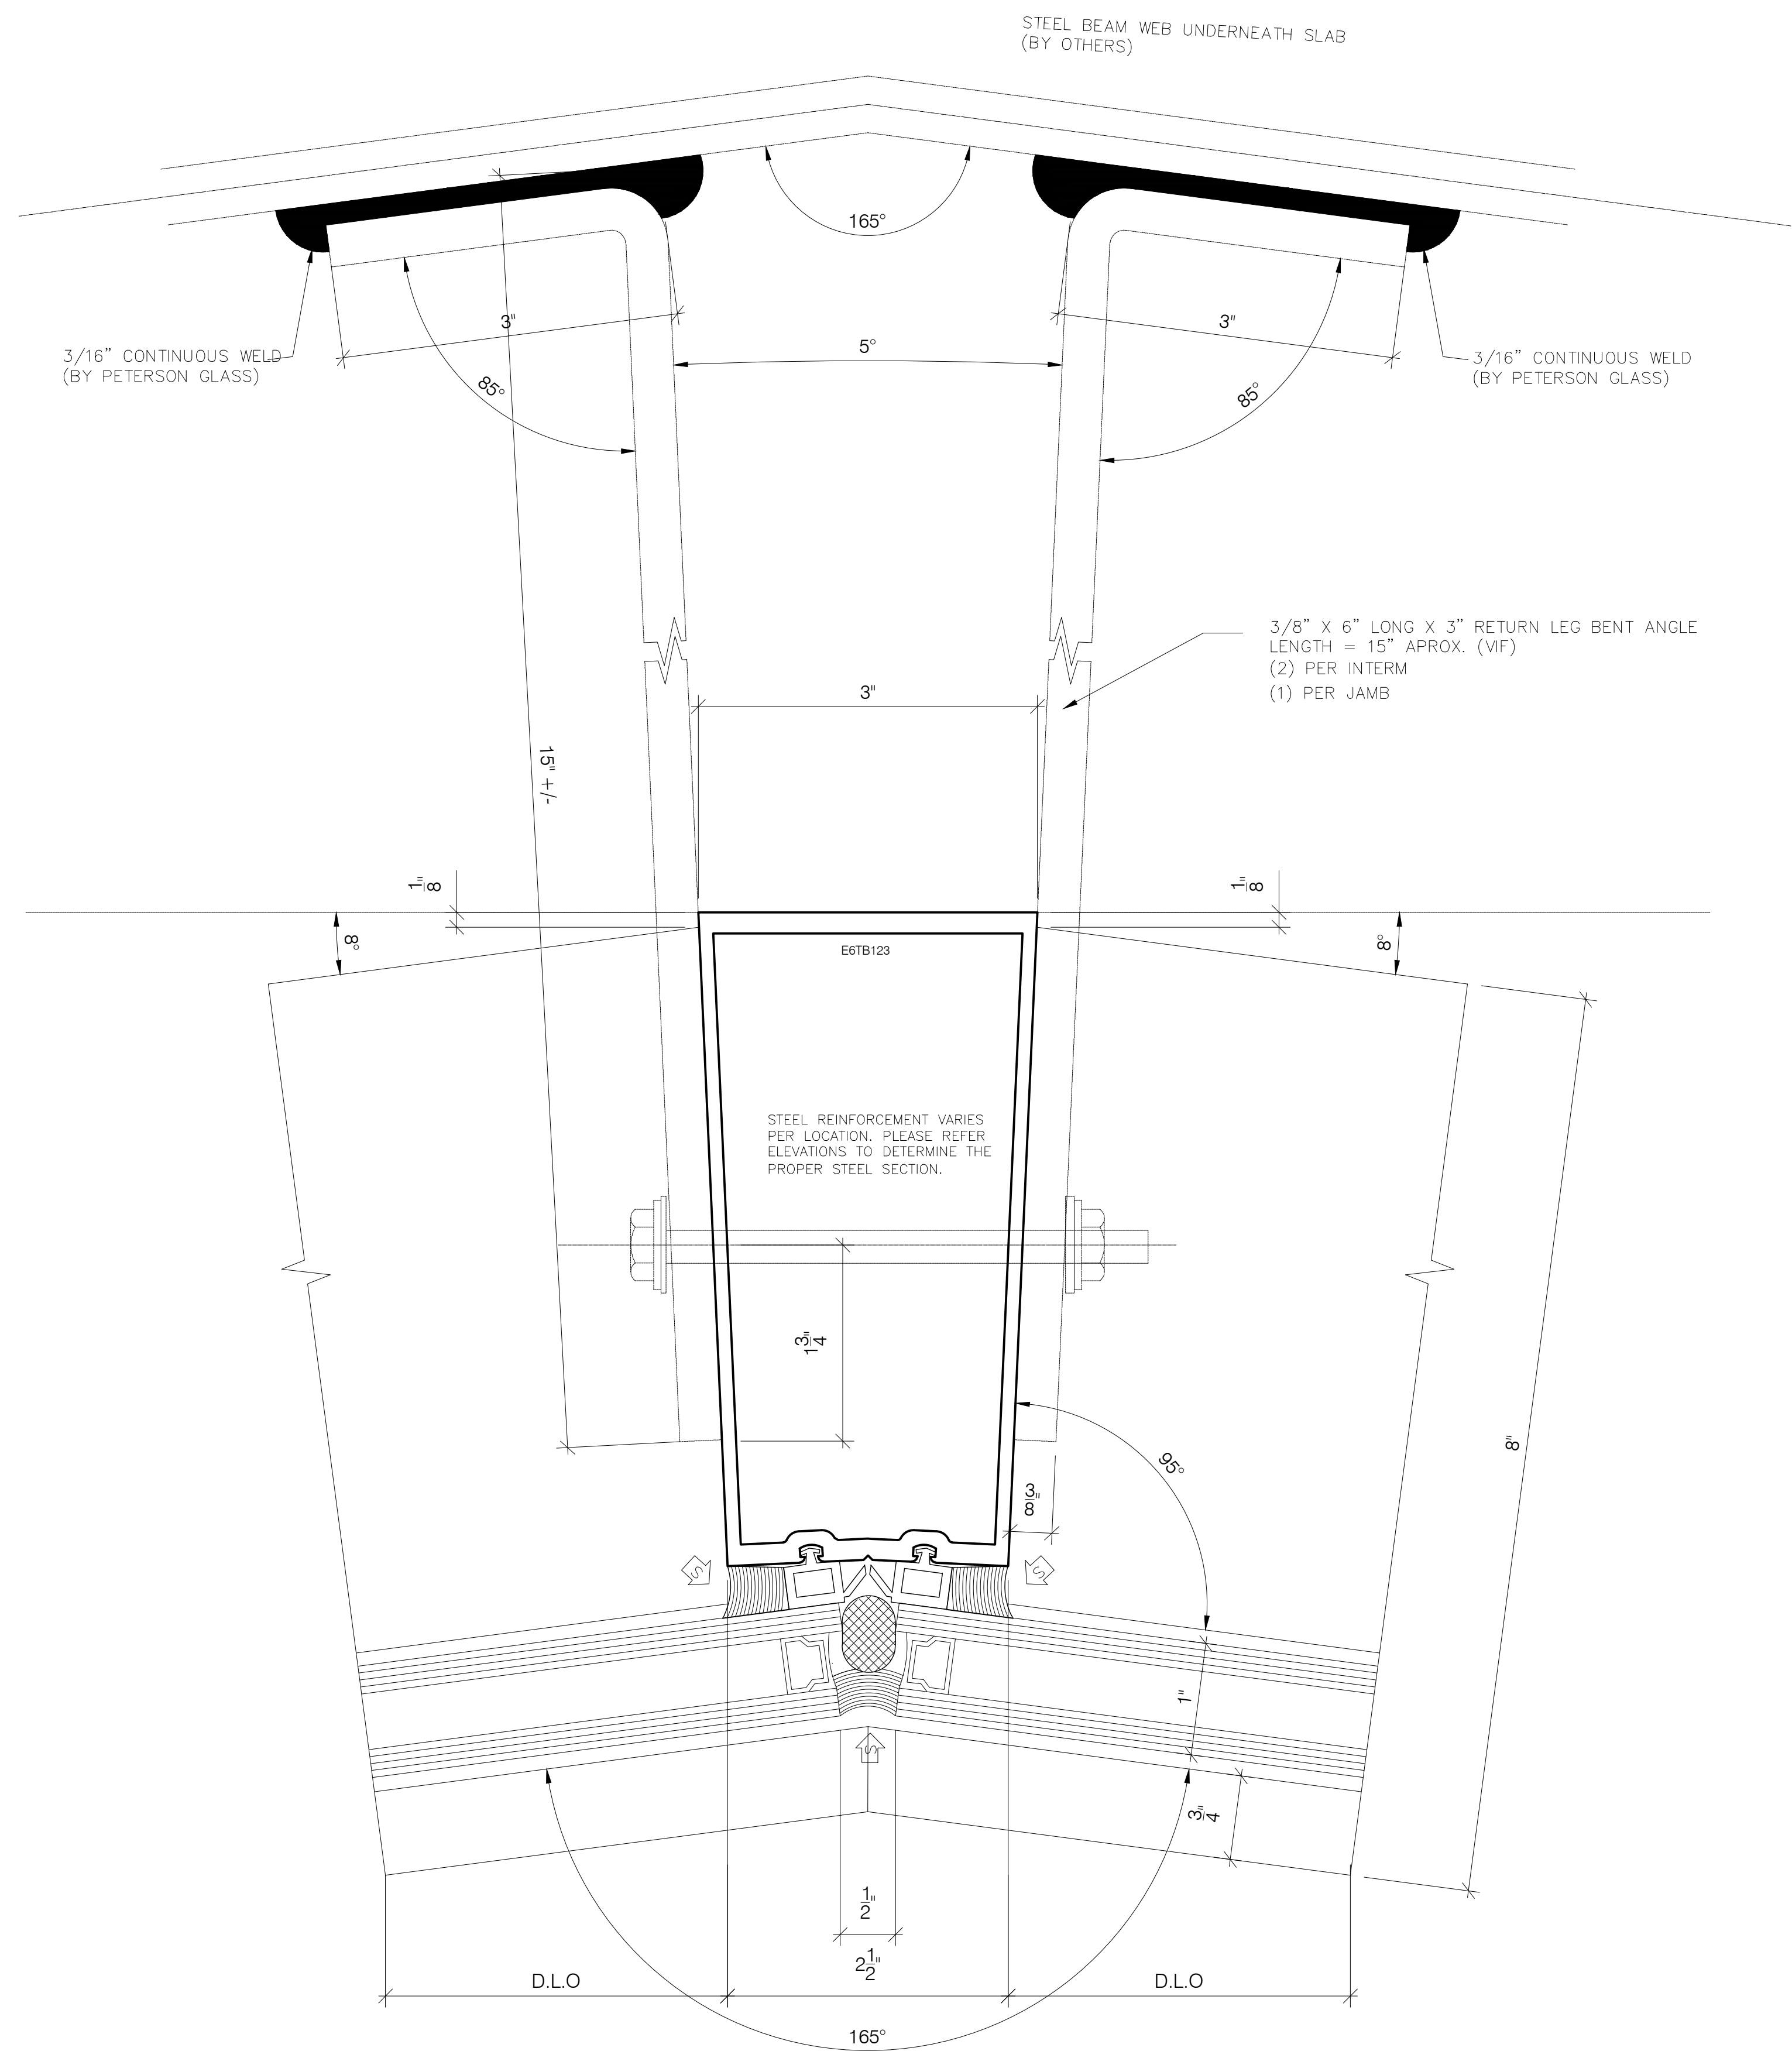



DETAIL 01 / 3.26
 HORZ. CUT
 Arch Reference: B3 / A10.23

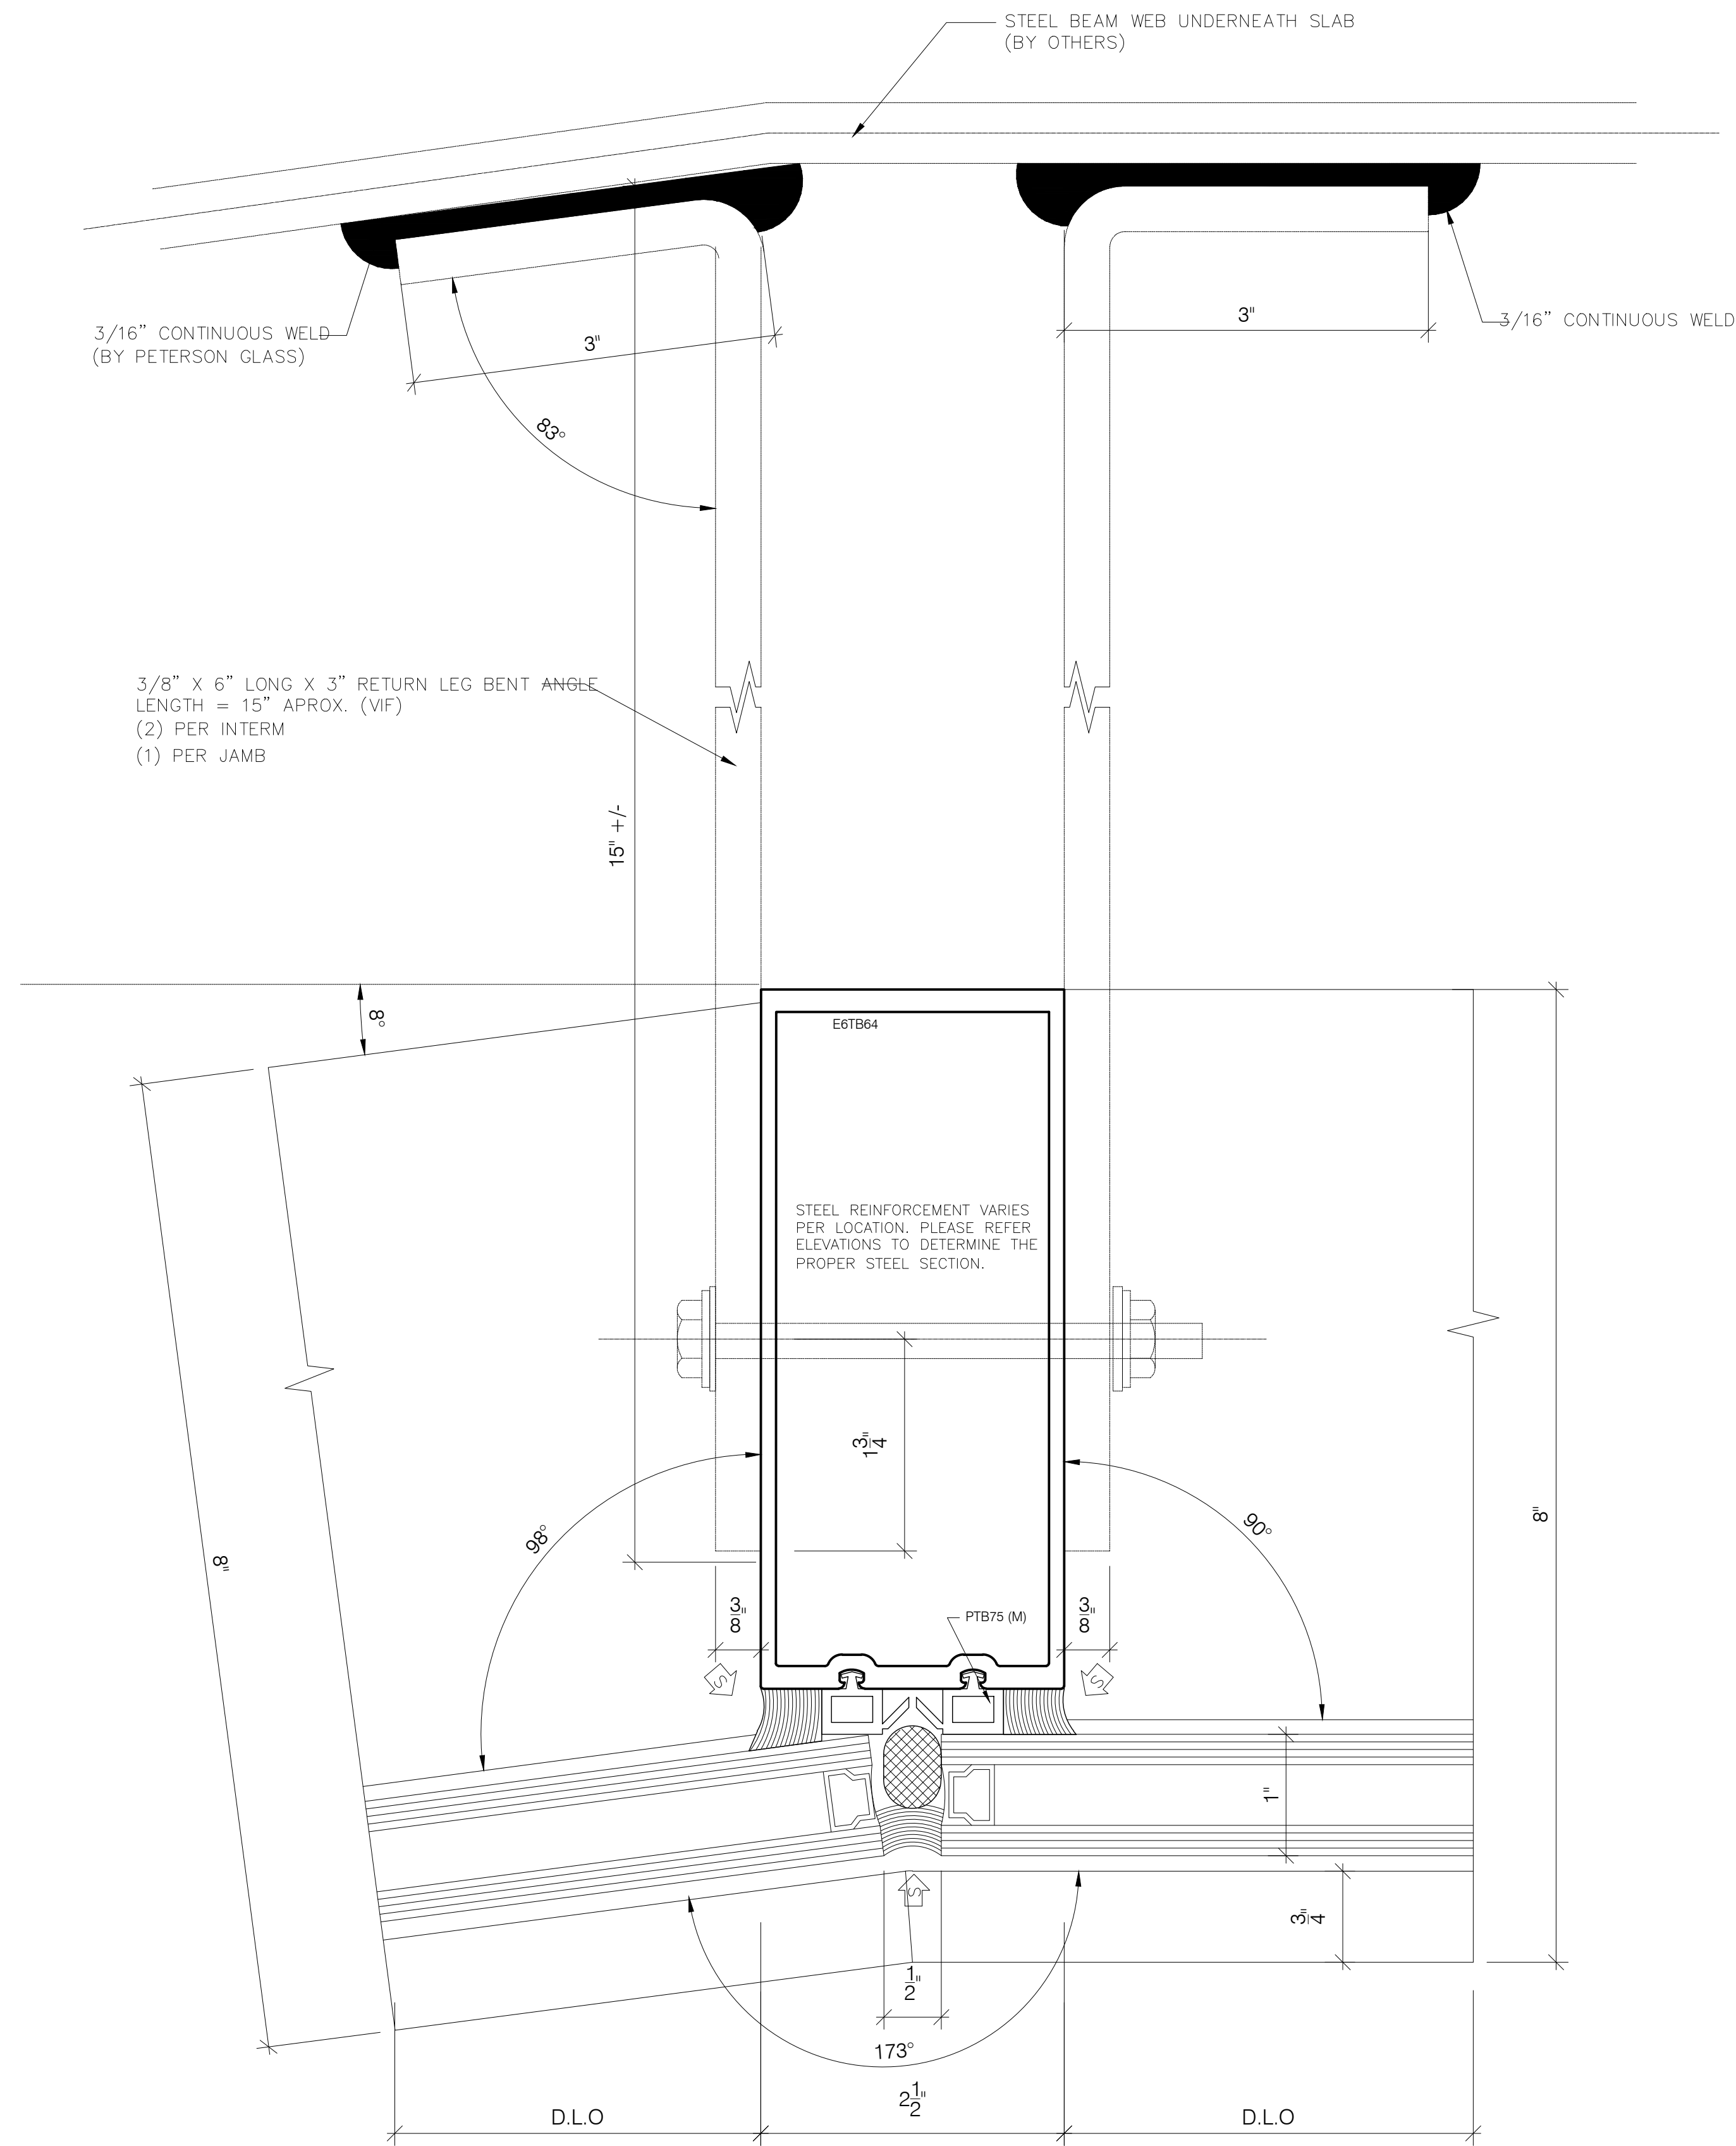



DETAIL 02 / 3.26
 HORZ. CUT
 Arch Reference: B3 / A10.23

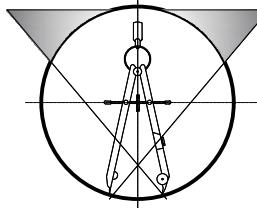GENERAL NOTES	REVISIONS	PROJECT:	UNIVERSITY OF MICHIGAN (SCHOOL OF NURSING)	 SABCAD, INC. PROFESSIONAL DRAWINGS P.O. BOX 338 CLAWSON, MI 48017 PH: (248) 635-9155 FAX: (248) 282-0595 www.sabcadinc.com		SHEET DESCRIPTION	SCALE: FULL
* ALL DIMENSIONS TO BE VERIFIED IN FIELD	FIRST ISSUE: 11/20/2013	PROJECT NO: 2011.153.00					
* ALL ELEVATIONS ARE VIEWED FROM OUTSIDE	02/24/2014	LAST UPDATE: 06-28-2013				DETAILS	
* ALL PARTS NO.(S) TO BE VERIFIED BY THE PURCHASING DEPARTMENT	06/02/2014	ARCHITECT: RDG Planning & Design					
	09/22/2014	Kallman McKinnell & Wood Architects				SABCAD JOB NO. 13-39	
		C.M: TURNER CONSTRUCTION COMPANY					SHEET NO. 3.26

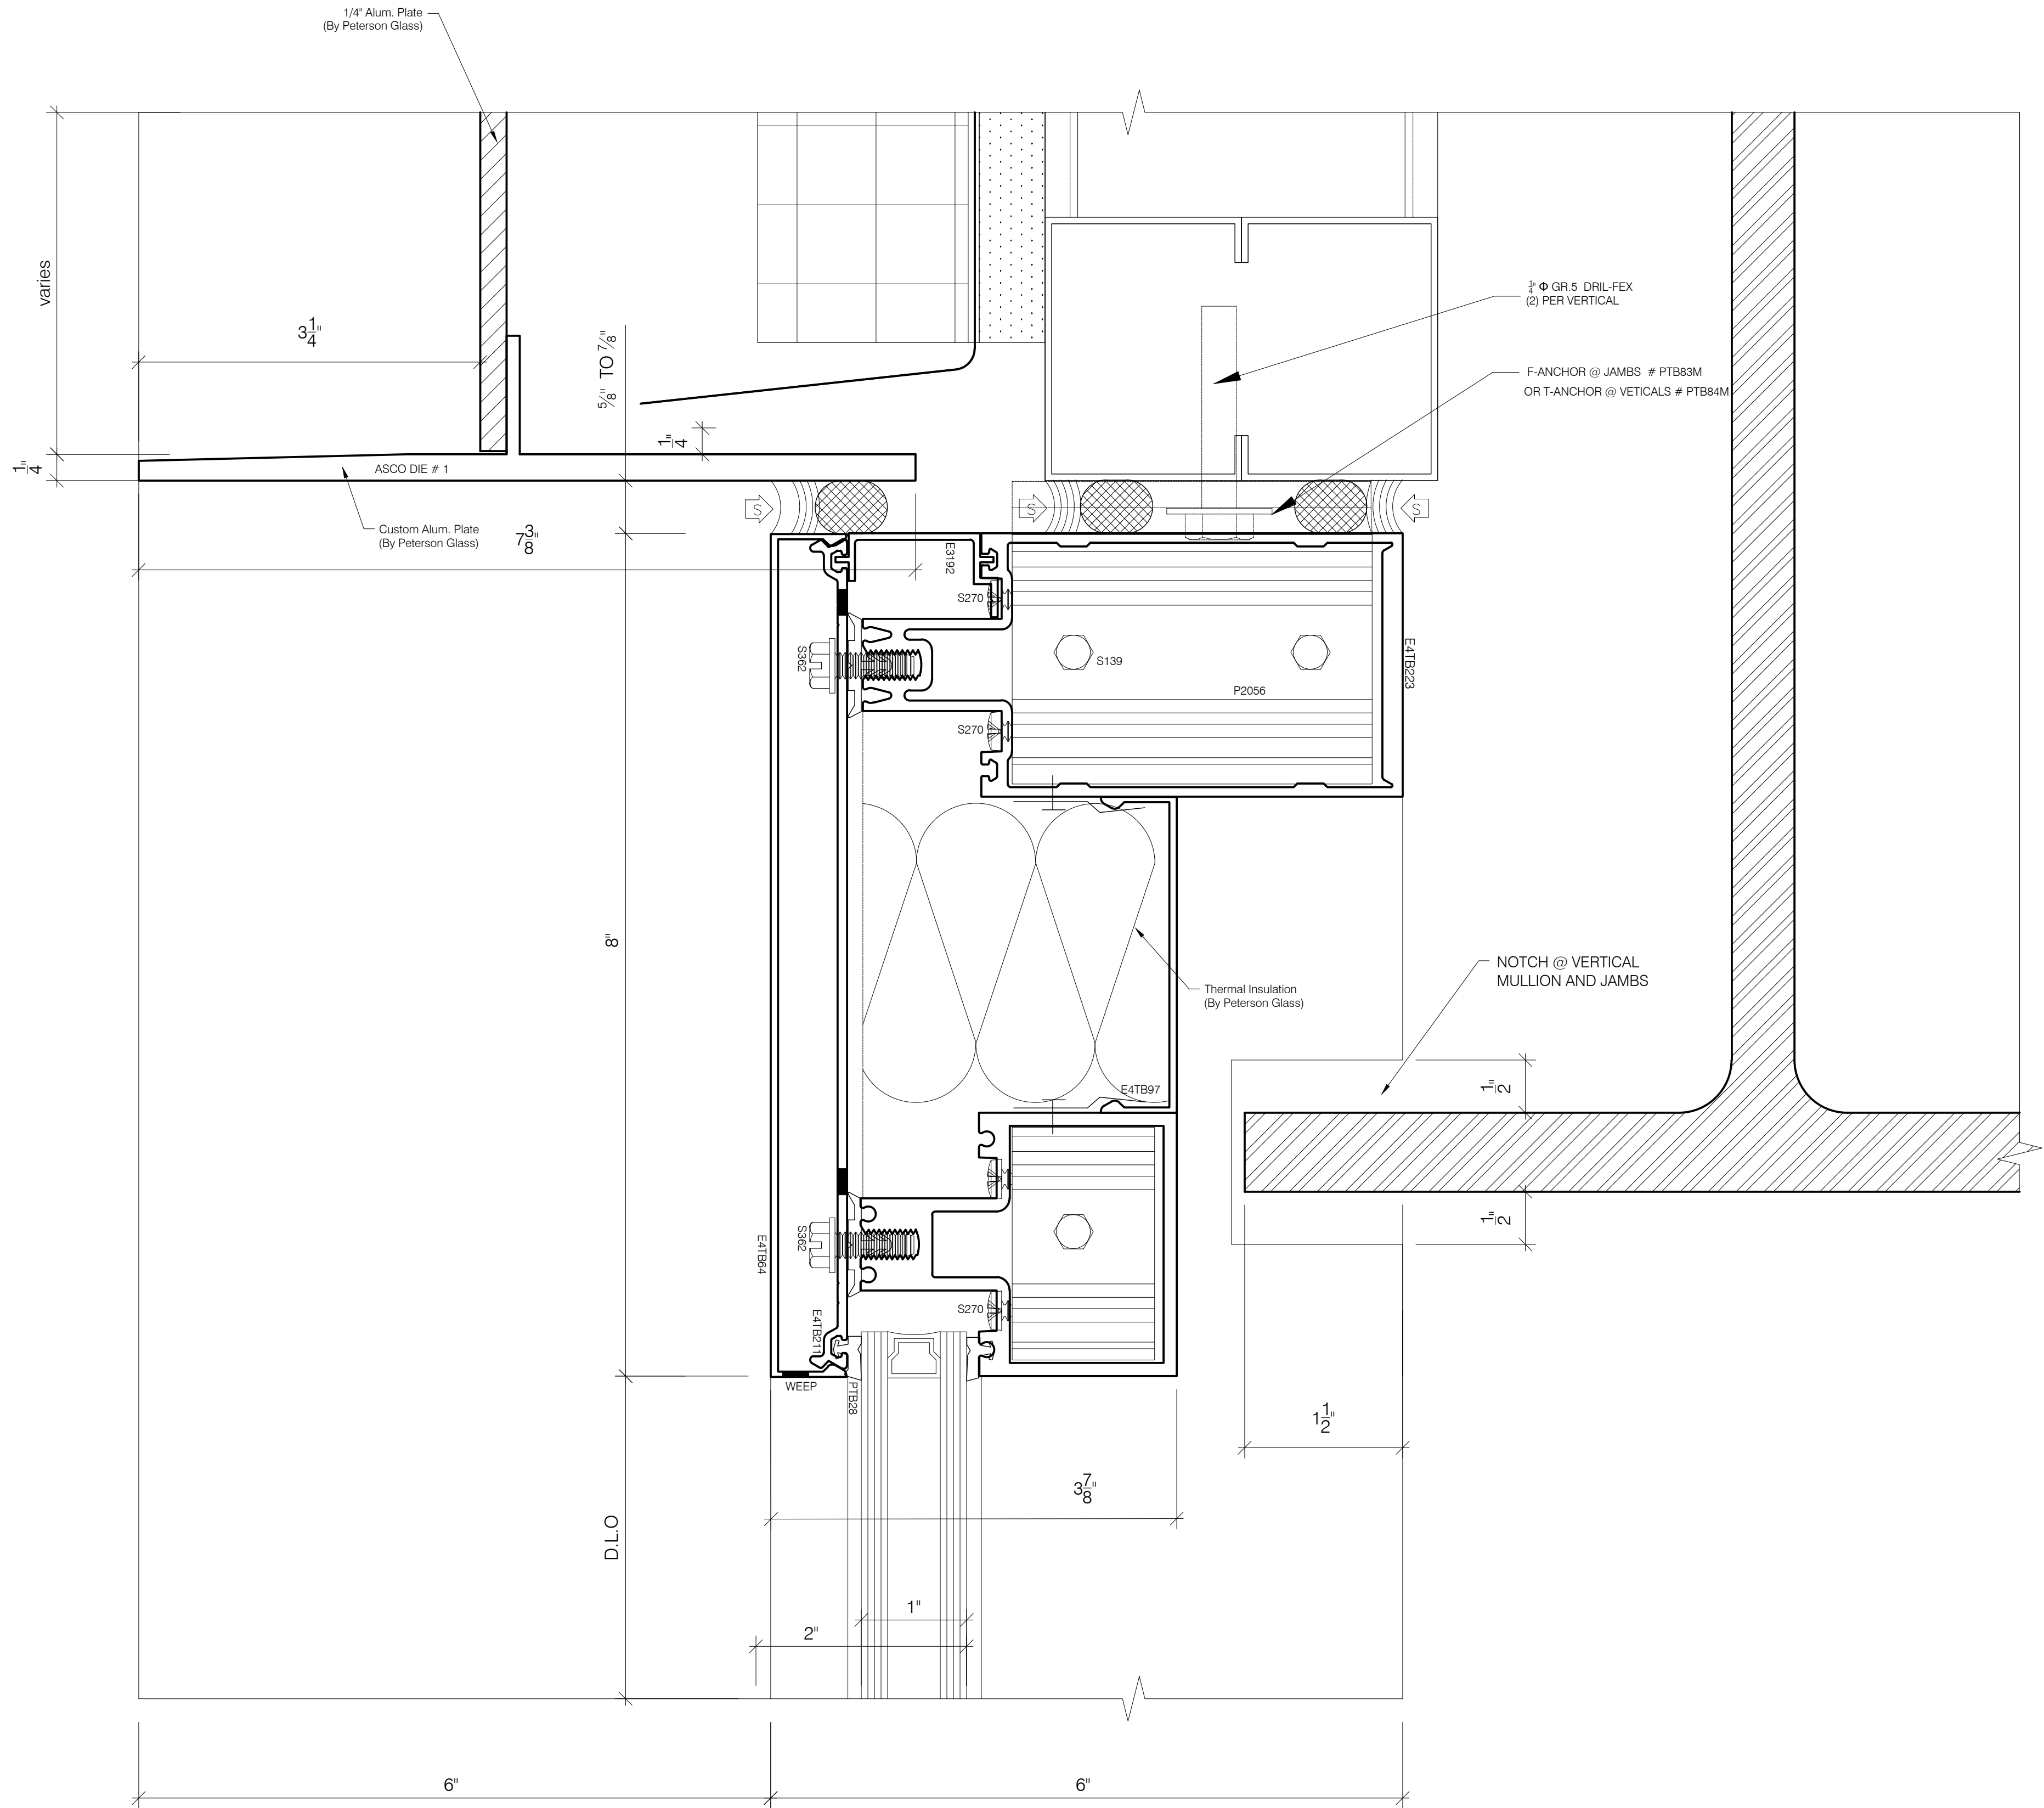

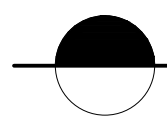
 **DETAIL 01 / 3.50**
VERT. CUT
Arch Reference: B4 / A09.11

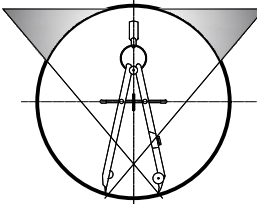GENERAL NOTES		REVISIONS		PROJECT: UNIVERSITY OF MICHIGAN (SCHOOL OF NURSING)		 SABCAD, INC. PROFESSIONAL DRAWINGS P.O BOX 336 CLAWSON, MI 48017 PH: (248) 635-9155 FAX: (248) 282-0595 www.sabcadinc.com	SHEET DESCRIPTION		SCALE: FULL	
* ALL DIMENSIONS TO BE VERIFIED IN FIELD		FIRST ISSUE:	11/20/2013	PROJECT NO:	2011.153.00		DETAILS		SHEET NO. 3.50	
			02/24/2014	LAST UPDATE:	06-28-2013					
* ALL ELEVATIONS ARE VIEWED FROM OUTSIDE			06/02/2014	ARCHITECT:	RDG Planning & Design Kallman McKinnell & Wood Architects					
		Engineering review and calculations	09/22/2014	C.M:	TURNER CONSTRUCTION COMPANY		SABCAD JOB NO. 13-39			
* ALL PARTS NO.(S) TO BE VERIFIED BY THE PURCHASING DEPARTMENT										

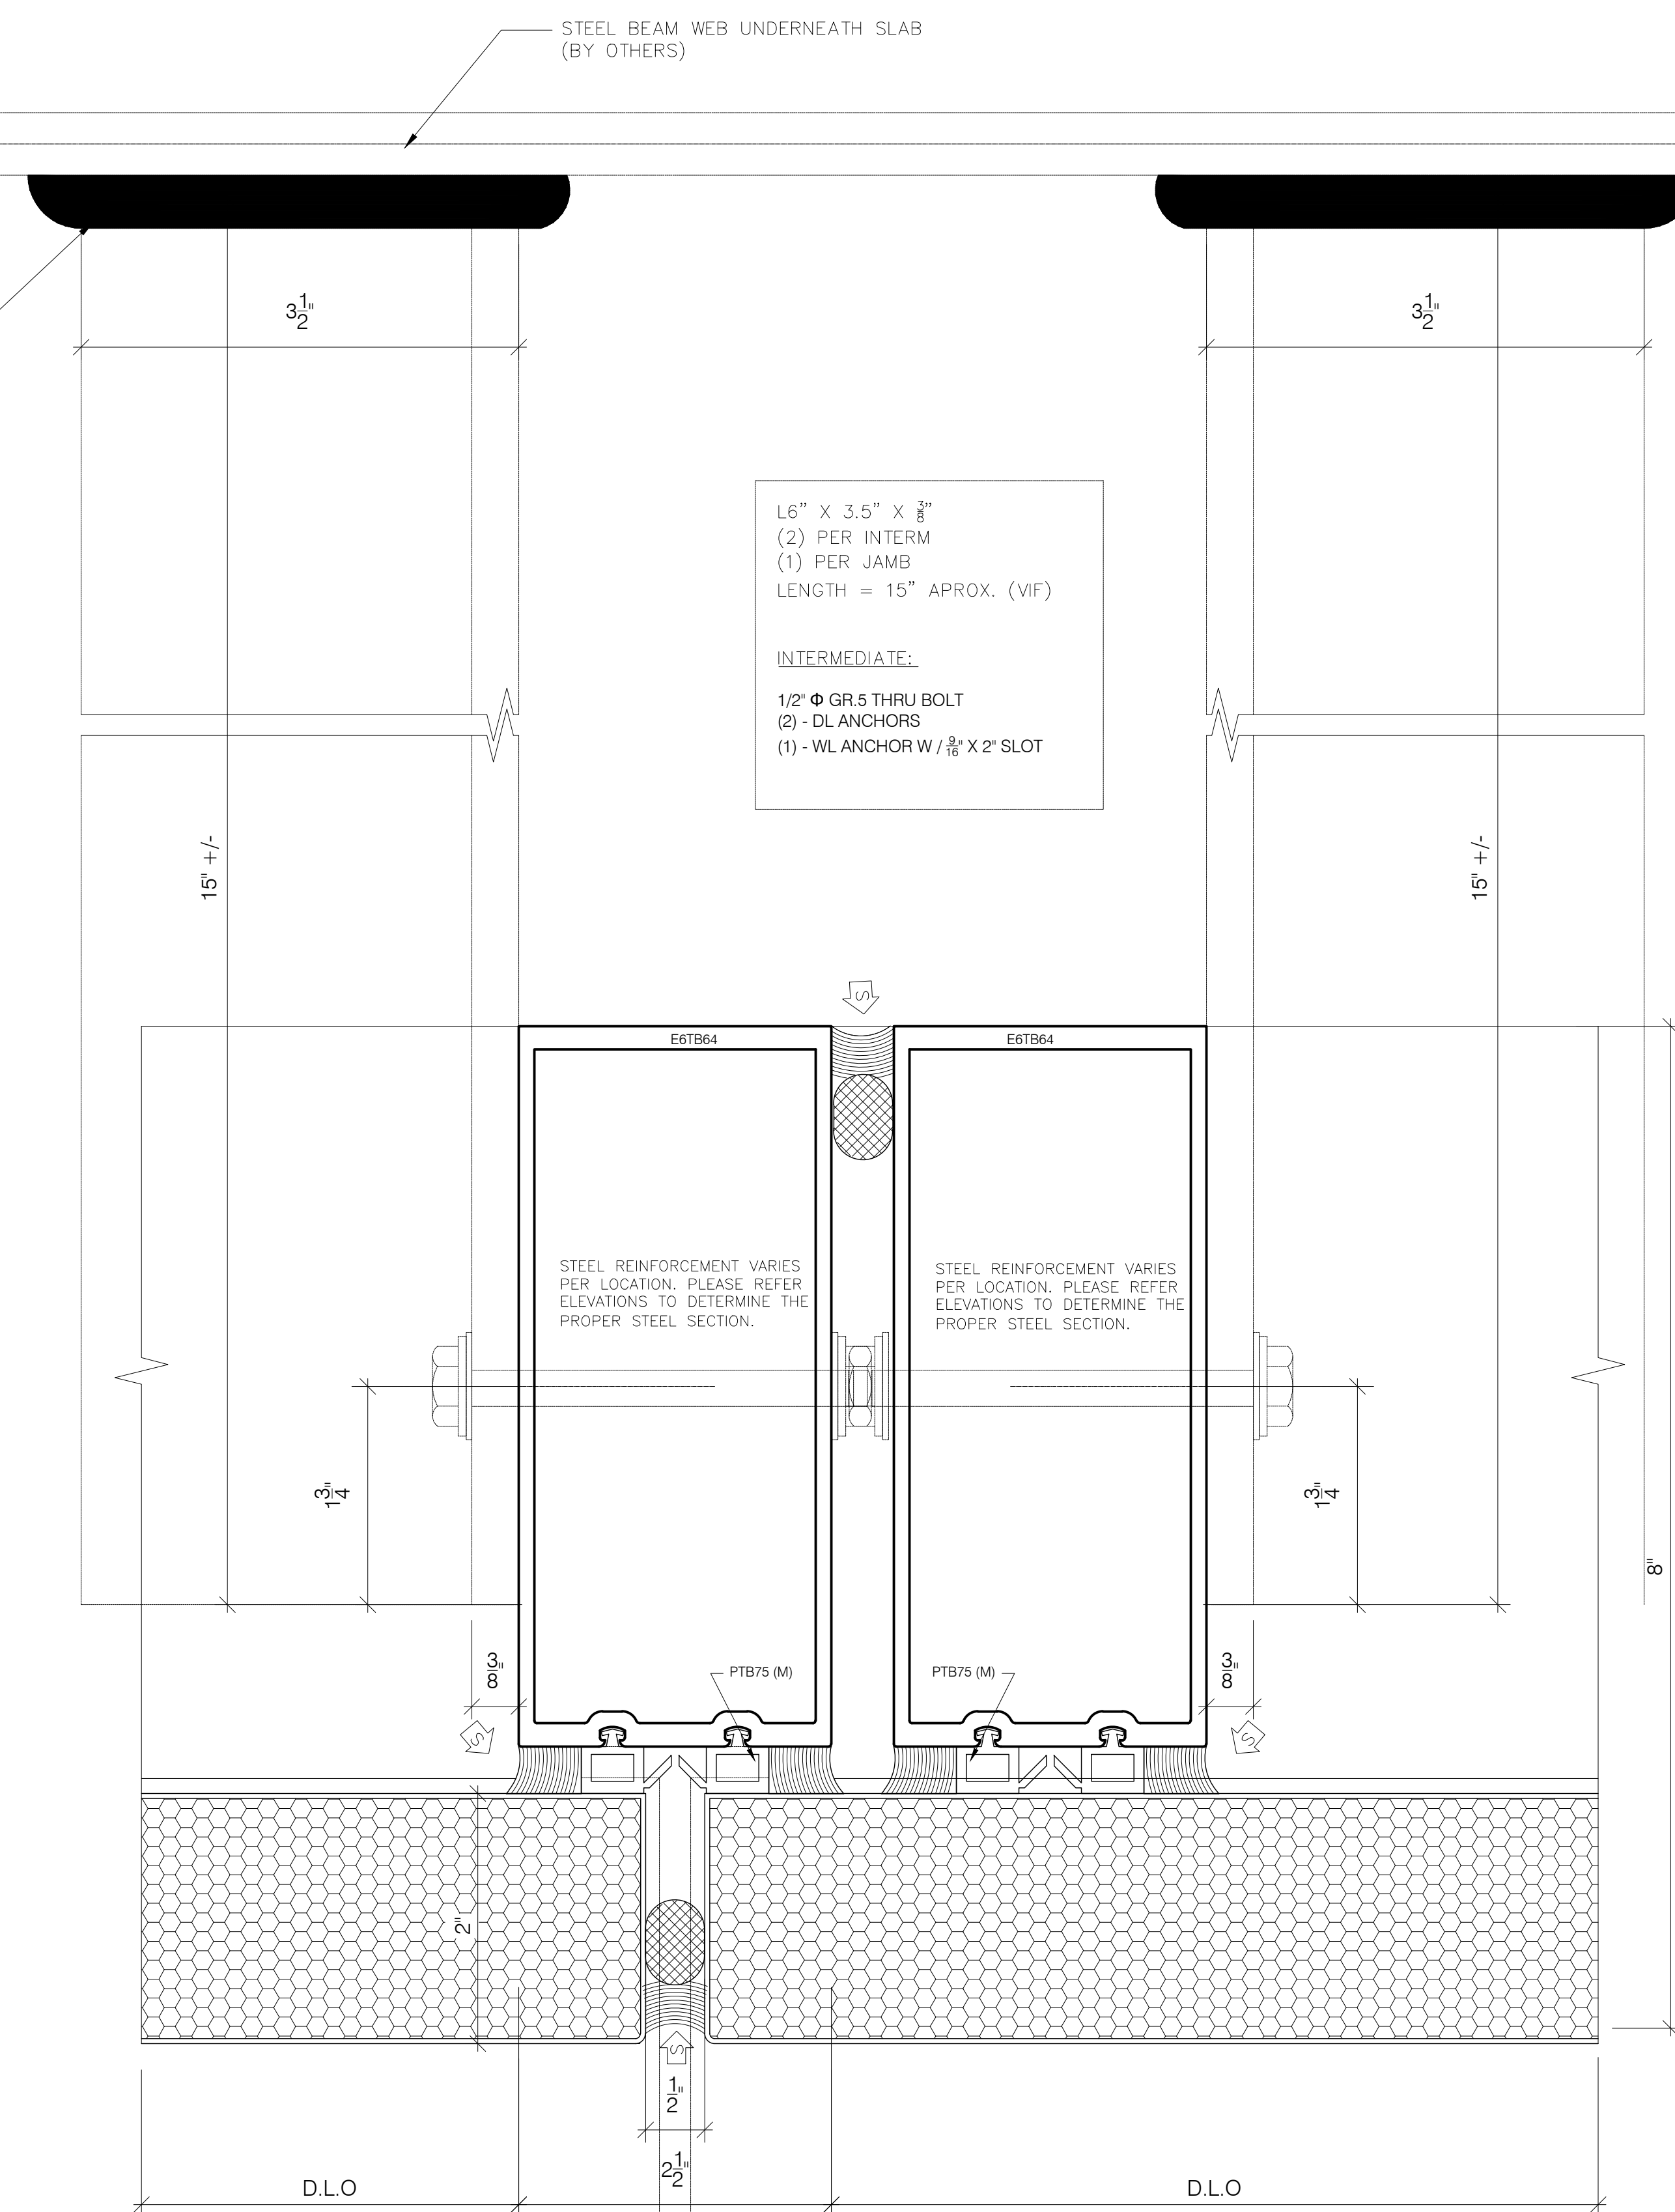

DETAIL 02 / 3.51

VERT. CUT

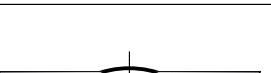GENERAL NOTES		REVISIONS		PROJECT: UNIVERSITY OF MICHIGAN (SCHOOL OF NURSING)		 SABCAD, INC. PROFESSIONAL DRAWINGS P.O. BOX 336 CLAWSON, MI 48017 PH: (248) 635-9155 FAX: (248) 282-0595 www.sabcadinc.com				SHEET DESCRIPTION DETAILS SABCAD JOB NO. 13-39		SCALE: FULL SHEET NO. 3.51	
* ALL DIMENSIONS TO BE VERIFIED IN FIELD		FIRST ISSUE: 11/20/2013  02/24/2014  06/02/2014  Engineering review and calculations 09/22/2014		PROJECT NO: 2011.153.00 LAST UPDATE: 06-28-2013 ARCHITECT: RDG Planning & Design Kallman McKinnell & Wood Architects C.M: TURNER CONSTRUCTION COMPANY									
* ALL ELEVATIONS ARE VIEWED FROM OUTSIDE													
* ALL PARTS NO.(S) TO BE VERIFIED BY THE PURCHASING DEPARTMENT													